

R10029
67477

Form OR-010-7300-2
4/83

UNITED STATES
DEPARTMENT OF THE INTERIOR
BUREAU OF LAND MANAGEMENT


Section 16
NESE

Township 31S
Range 26E

Appl. No. R-67380
Permit No. R10029

Will. Mer.

Rocky Draw Reservoir # 5245

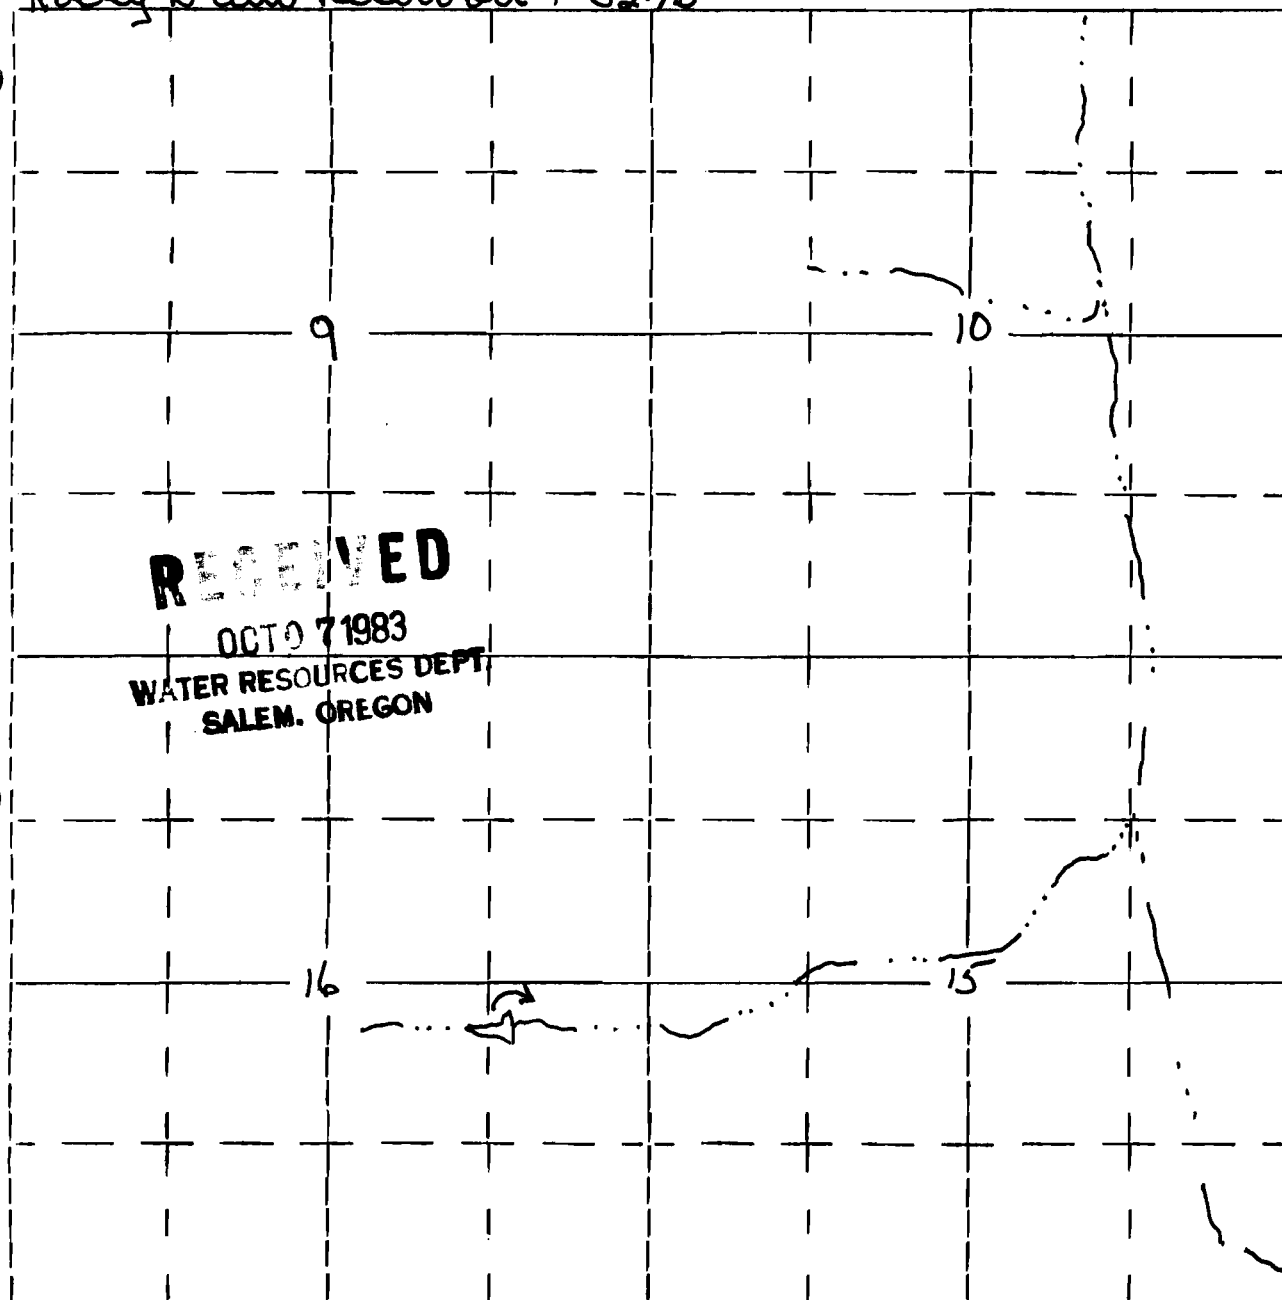

2250'N 850'W of SE corner of section 16