R8959
67478

Form OR-010-7300-2
4/83

UNITED STATES
DEPARTMENT OF THE INTERIOR
BUREAU OF LAND MANAGEMENT

Section 24 NE NW

Township 34 south

Range 22 east

Will. Mer.

Appl. No. R-67381

Permit No. R 8959

Party Reservoir (#1487)

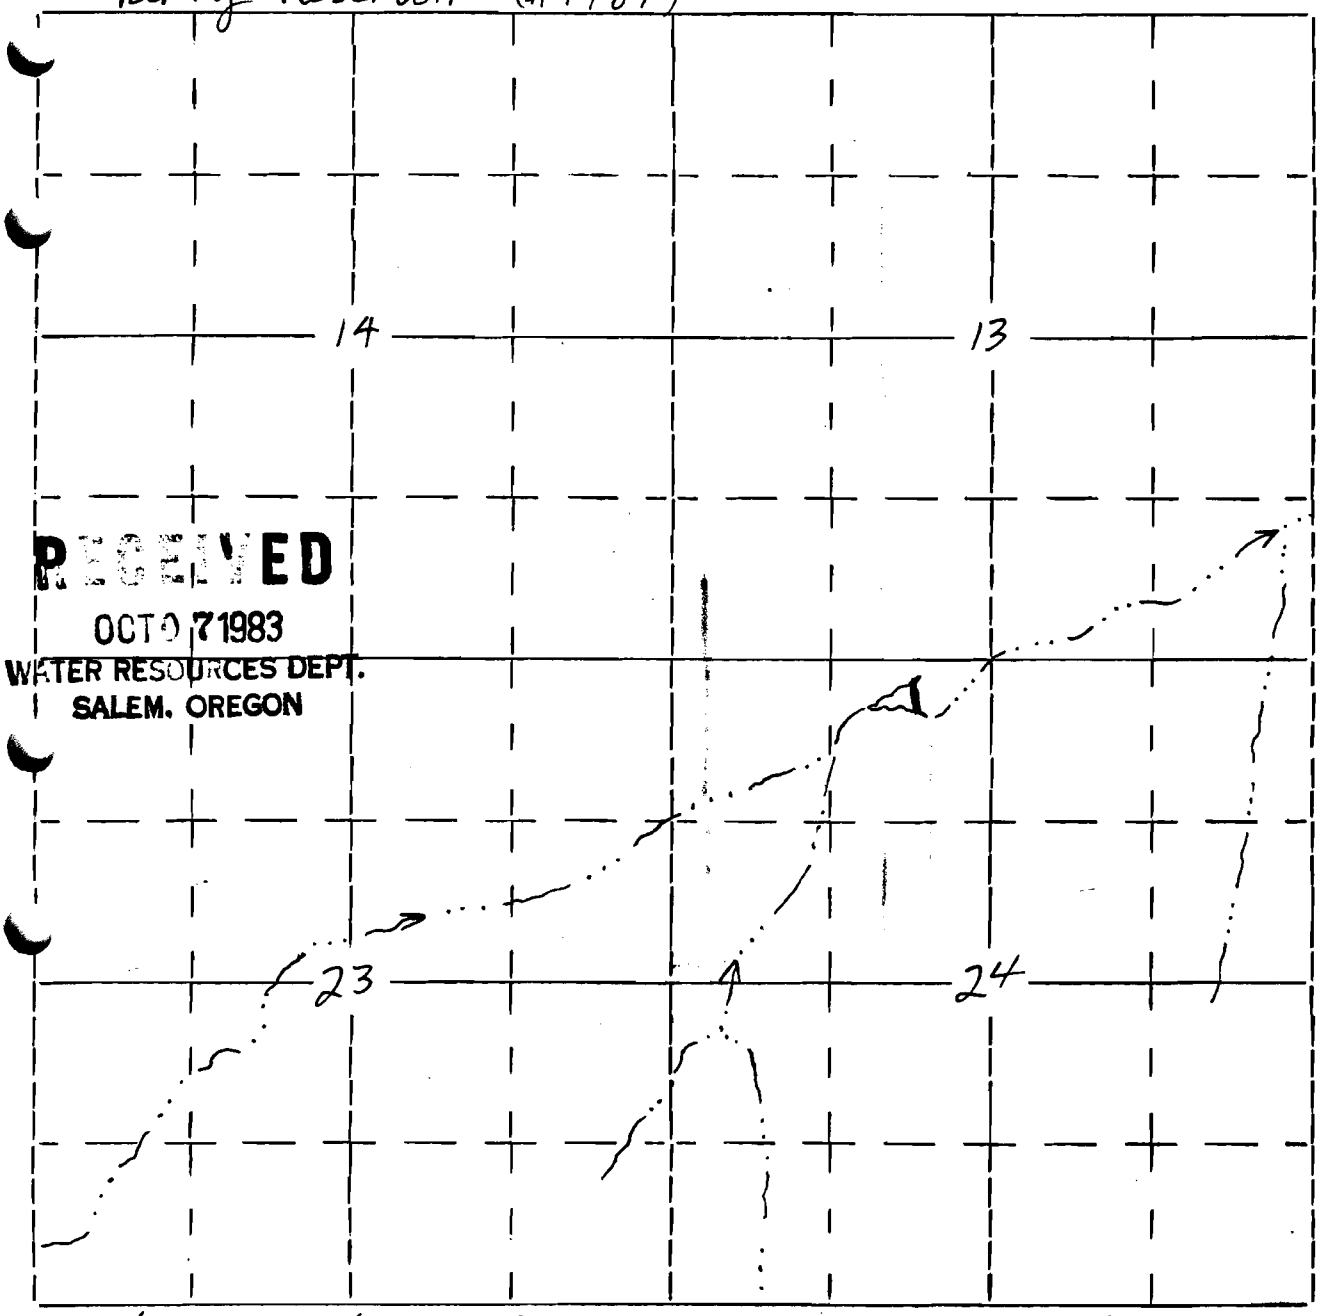

RECEIVED
OCT 07 1983
WATER RESOURCES DEPT.
SALEM, OREGON

330' S., 1485' E. of NW Corner of Section 24