

R 8962
67479

Form OR-010-7300-2
4/83

UNITED STATES
DEPARTMENT OF THE INTERIOR
BUREAU OF LAND MANAGEMENT

Section

30

Township 30S

Appl. No. R-67384


NWSW

Range 27E

Permit No. R 8962

Will. Mer.

Hole Waterhole (#0941)

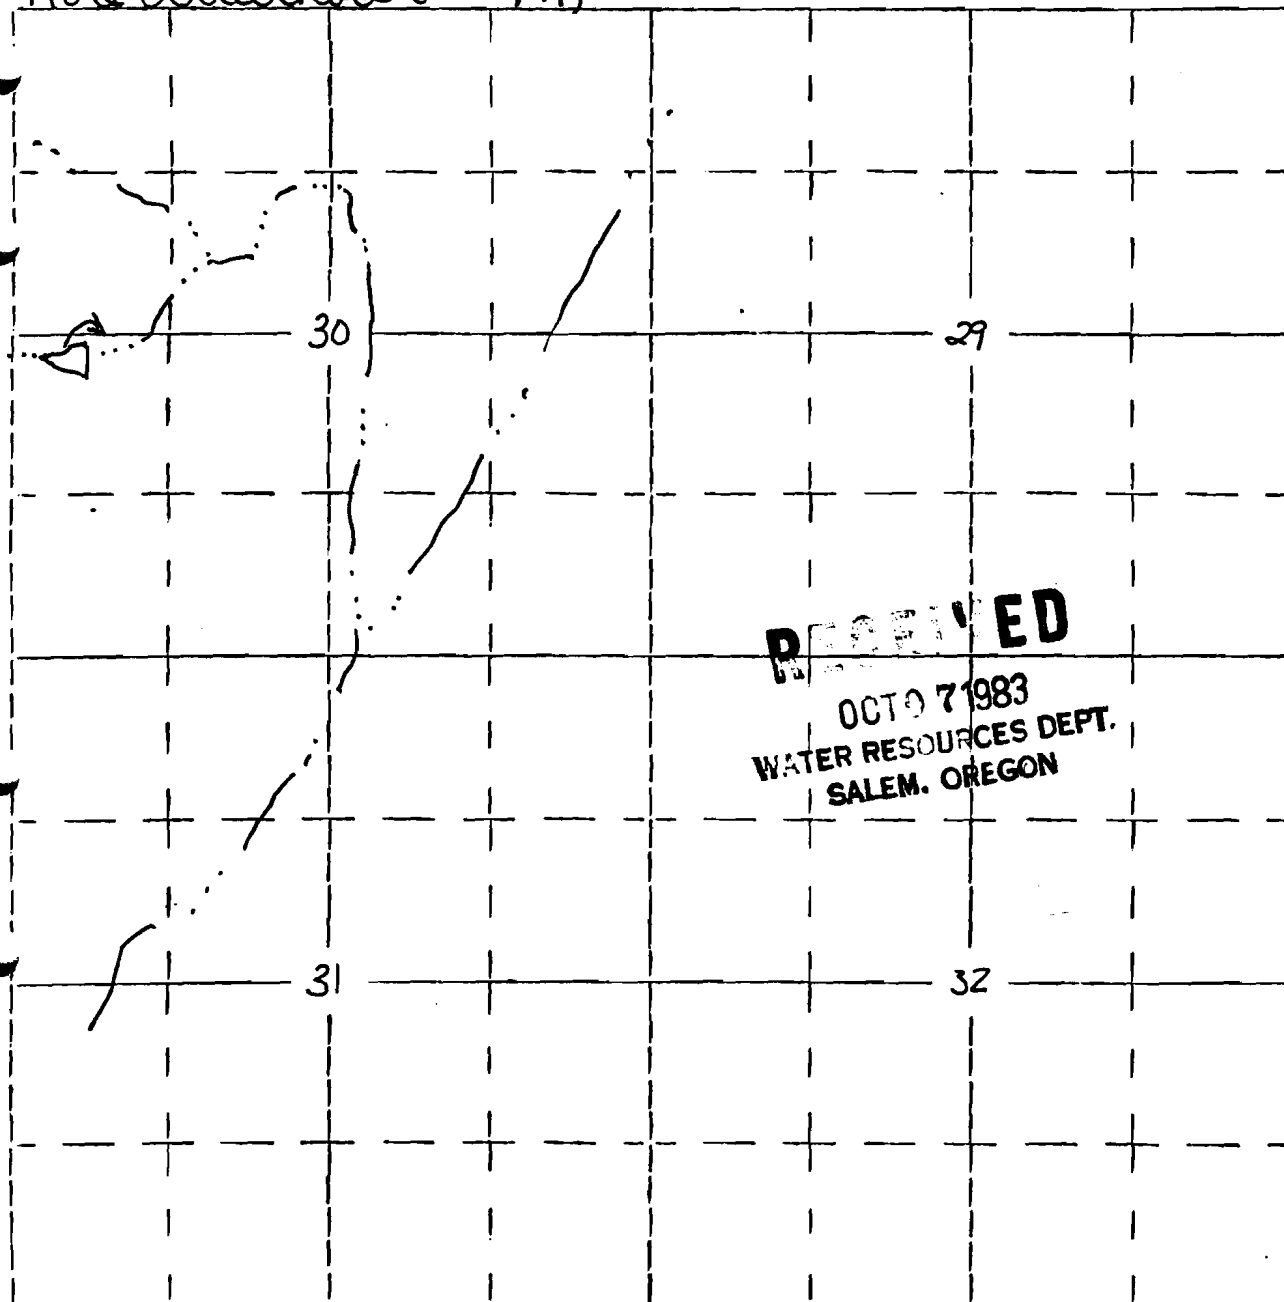

2550N, 150'E of SW corner of section 30