

R 8966
67481

Form OR-010-7300-2
4/83

UNITED STATES
DEPARTMENT OF THE INTERIOR
BUREAU OF LAND MANAGEMENT

Section

10

Township 29S

Appl. No. R-67388


SESE

Range 24E

Permit No. R 8966

Will. Mer.

Dead Juniper Reservoir 1566

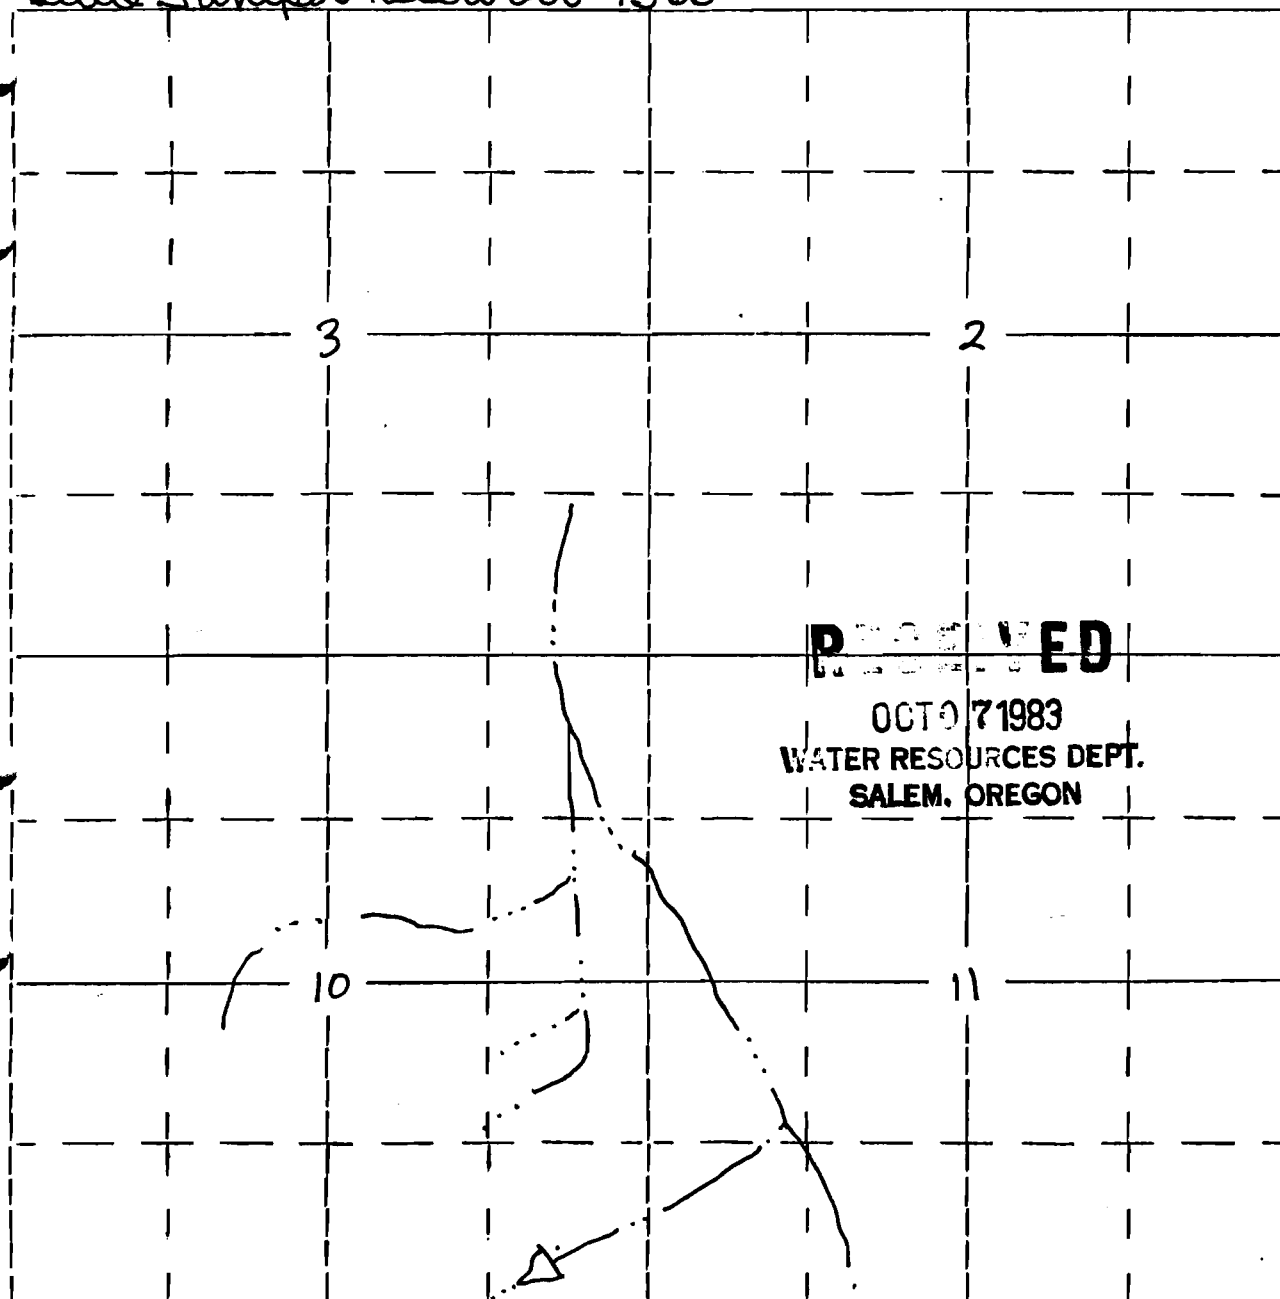

500' N, 1000' W of the SE corner of section 10