

R8973
67485

Form OR-010-7300-2
4/83

UNITED STATES
DEPARTMENT OF THE INTERIOR
BUREAU OF LAND MANAGEMENT


Section 12
SESE

Township 39S
Range 23E

Appl. No. R-67396
Permit No. R 8973

Will. Mer.

Split Reservoir 0978

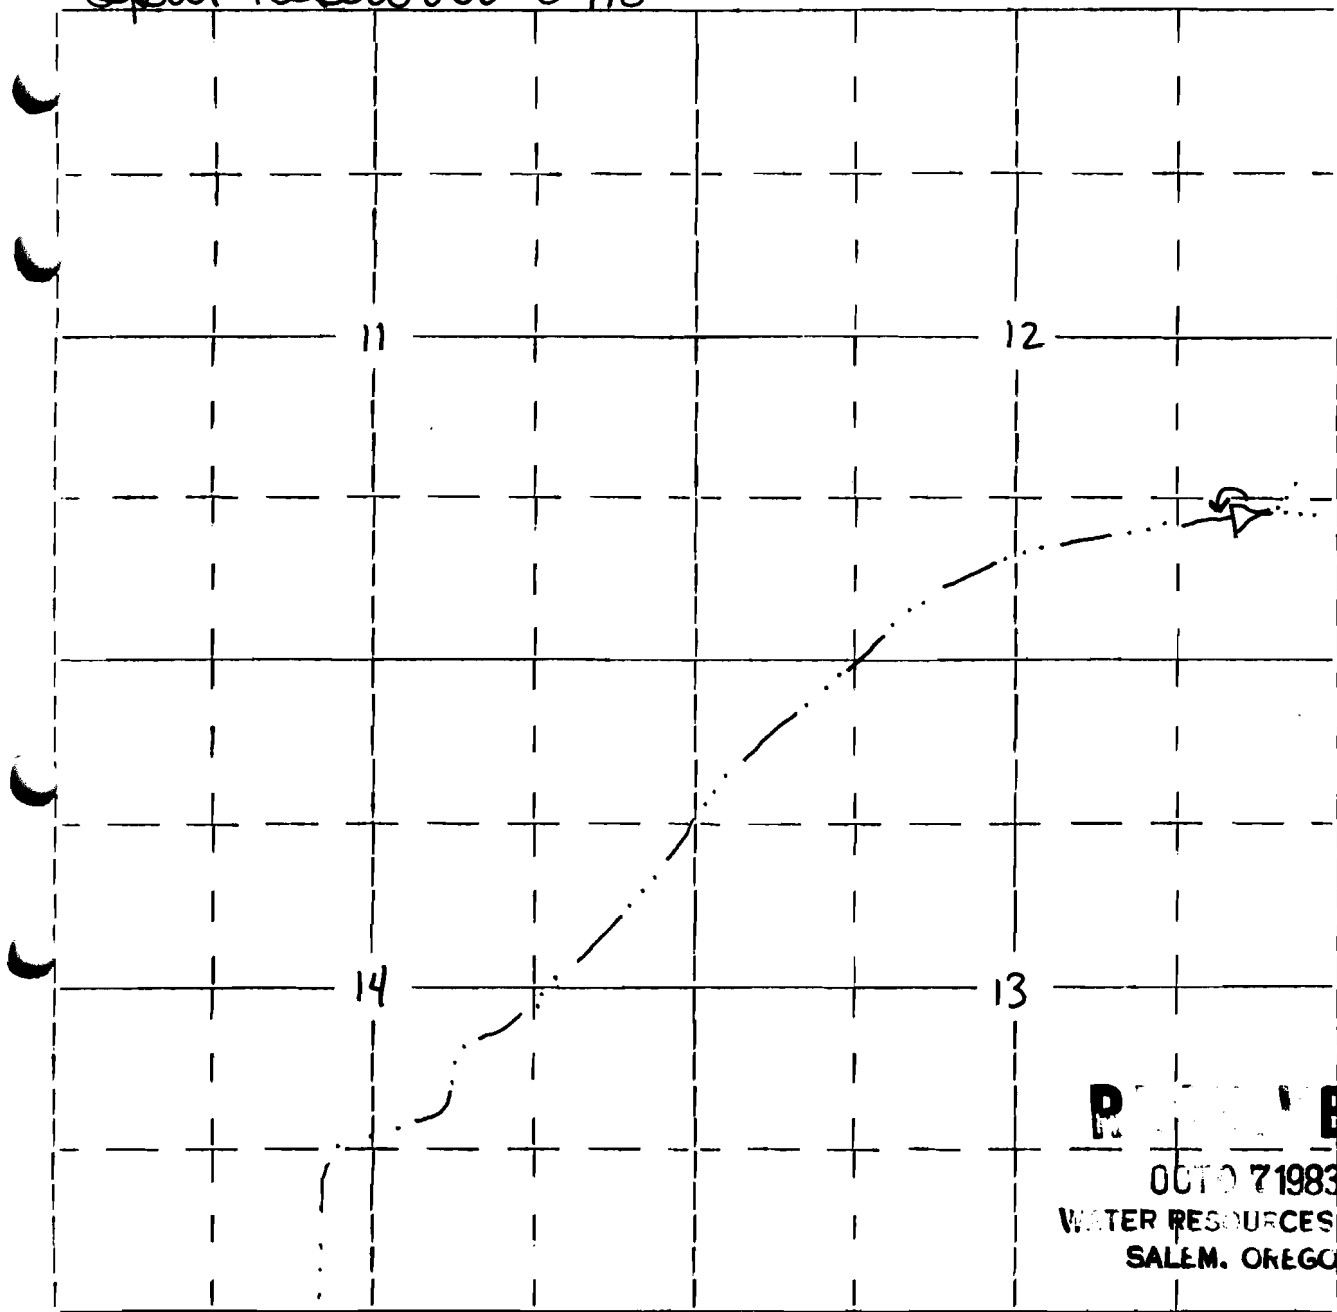

RECEIVED

OCT 07 1983
WATER RESOURCES DEPT.
SALEM, OREGON

1350' N. 850' W. of SE corner of Section 12