

R8975
67487

Form OR-010-7300-2
4/83

UNITED STATES
DEPARTMENT OF THE INTERIOR
BUREAU OF LAND MANAGEMENT

Section 8

Township 39S

Appl. No. R-67398


NWSE

Range 26E

Permit No. R 8975

Will. Mer.

Soble Reservoir 1526

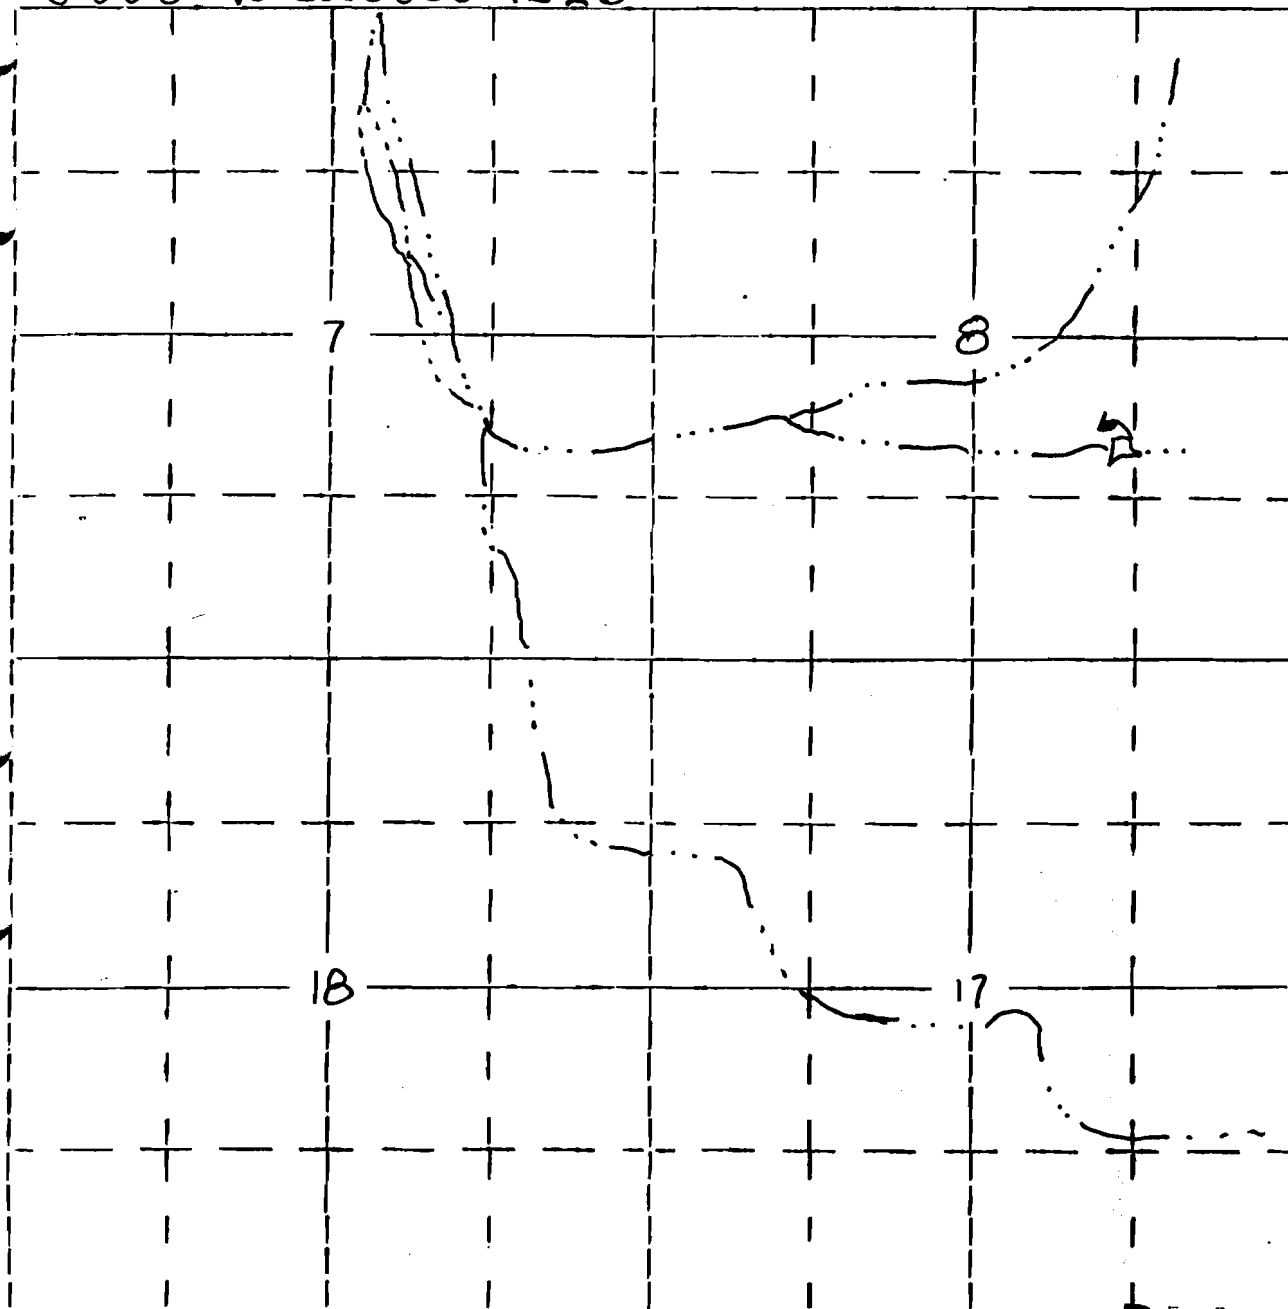

1700' N 1600' W of the SE corner of section 8

RECEIVED

OCT 07 1983
WATER RESOURCES DEPT.
SALEM, OREGON