

R8976
67488

Form OR-010-7300-2
4/83

UNITED STATES
DEPARTMENT OF THE INTERIOR
BUREAU OF LAND MANAGEMENT

Section 6
SESE


Township 39S
Range 26E

Appl. No. R-67399

Permit No. R 8976

Will. Mer.

Synne Reservoir 1527

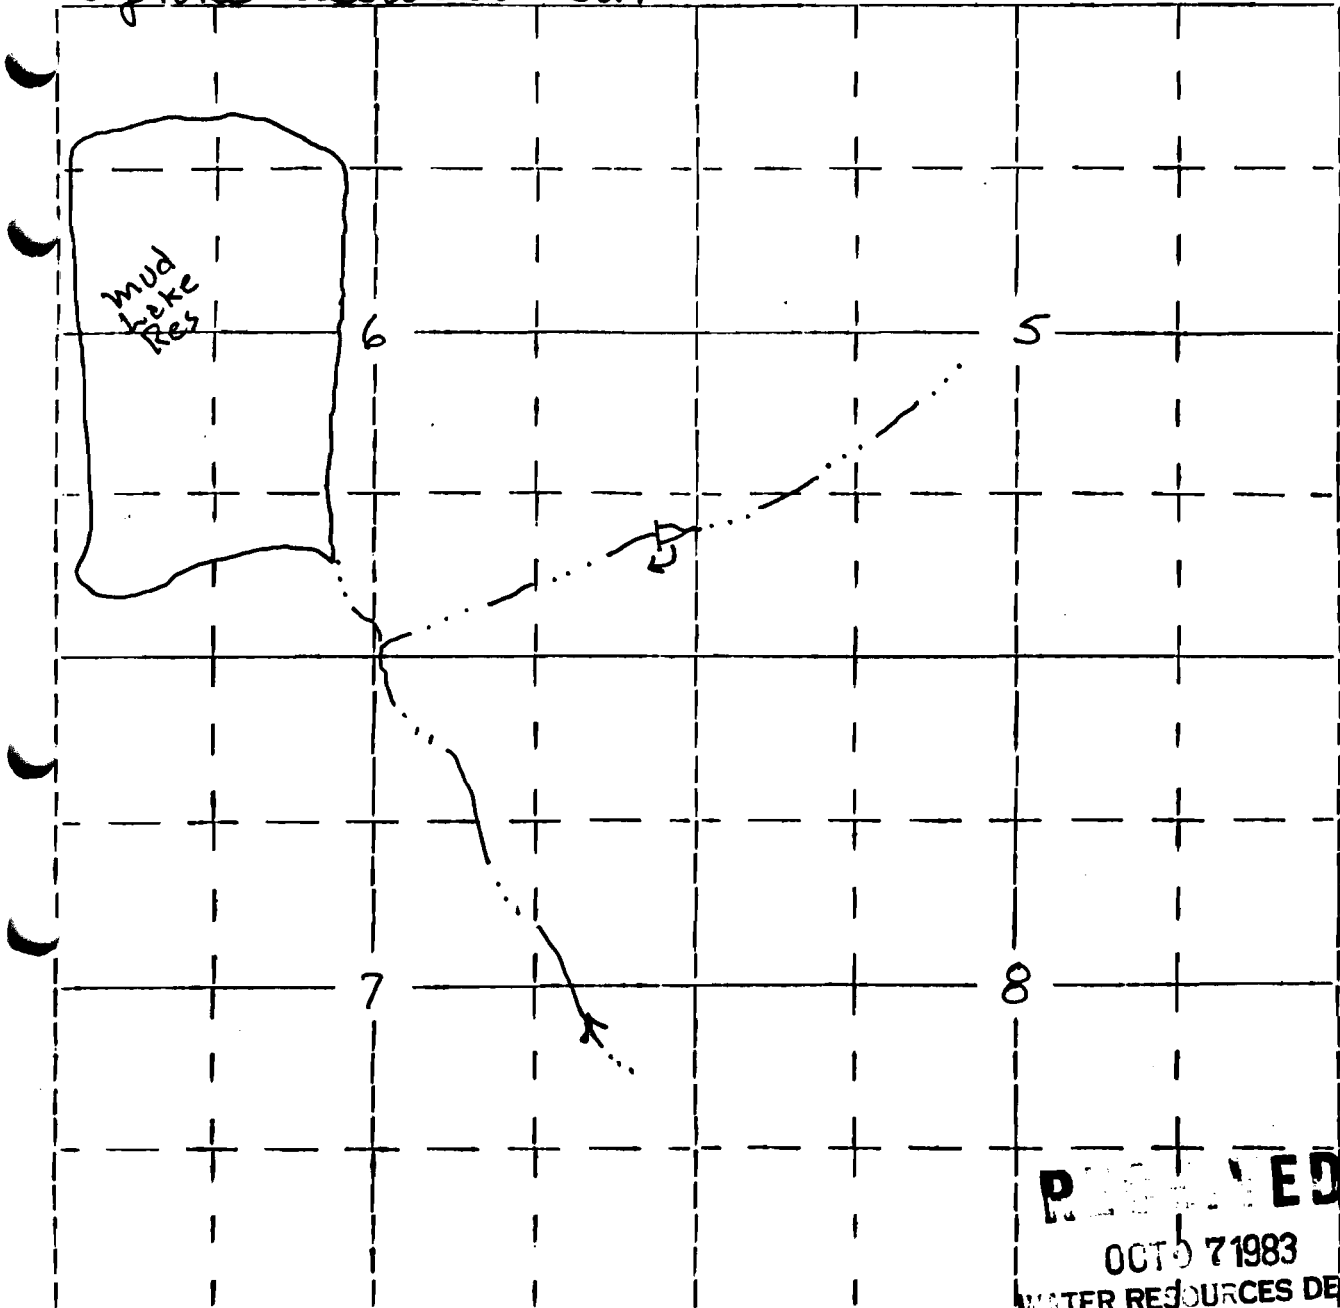

1100' N 250' W of SE corner of section 6

RECEIVED
OCT 7 1983
WATER RESOURCES DEPT.
SALEM, OREGON