

R8982
67490

Form OR-010-7300-2
4/83

UNITED STATES
DEPARTMENT OF THE INTERIOR
BUREAU OF LAND MANAGEMENT

Section 8
N E N E


Township 39 S
Range 27 E

Appl. No. R-67405

Permit No. R 8982

Will. Mer.

Section 9 Reservoir 5027

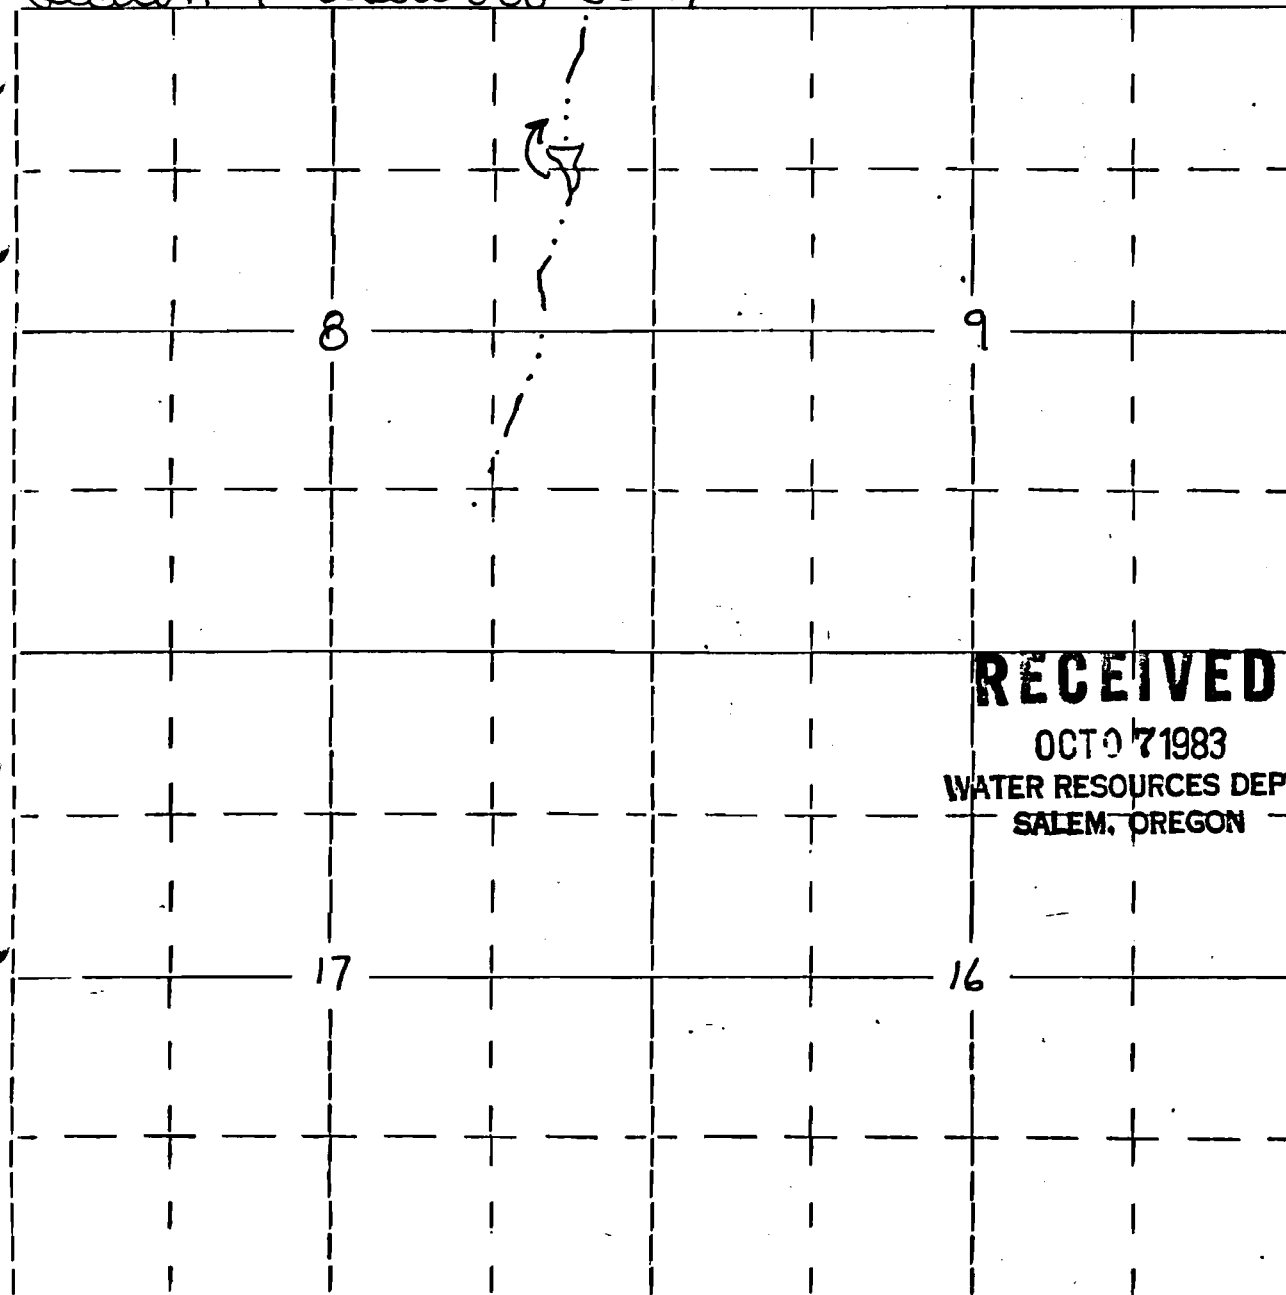

RECEIVED

OCT 07 1983

WATER RESOURCES DEPT.
SALEM, OREGON

1300'S, 700'W of NE corner of section 8