

R 8983
67491

Form OR-010-7300-2
4/83

UNITED STATES
DEPARTMENT OF THE INTERIOR
BUREAU OF LAND MANAGEMENT

Section

32

Township 30 South

Appl. No. R-67407


NWNE

Range 24 East

Permit No. R 8983

Will. Mer.

Guys Waterhole (#0372)

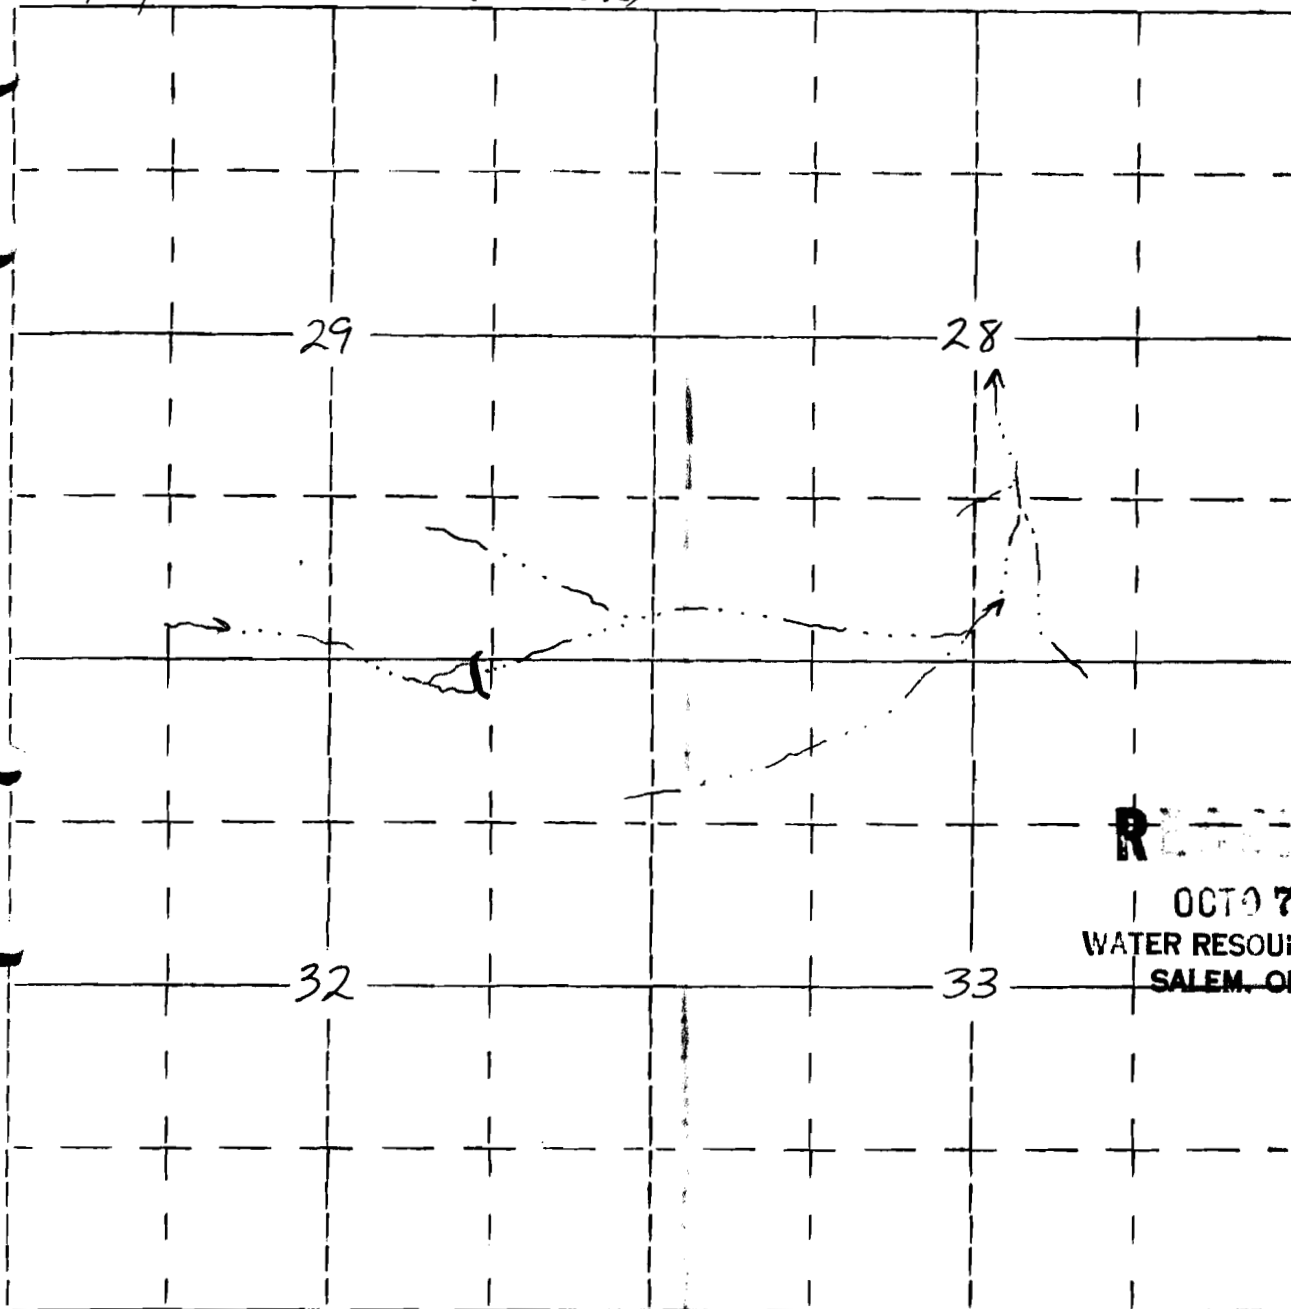

110' S., 1520' W. of NW Corner of Sec. 32