

R 8988
67492

Form OR-010-7300-2
4/83

UNITED STATES
DEPARTMENT OF THE INTERIOR
BUREAU OF LAND MANAGEMENT

Section
01
SWSE

Township 30 South
Range 23 East

Appl. No. R-67413


Permit No. R 8988

Will. Mer.

Sheep Reservoir (#1201)

RECEIVED

OCT 07 1983
WATER RESOURCES DEPT.
SALEM, OREGON

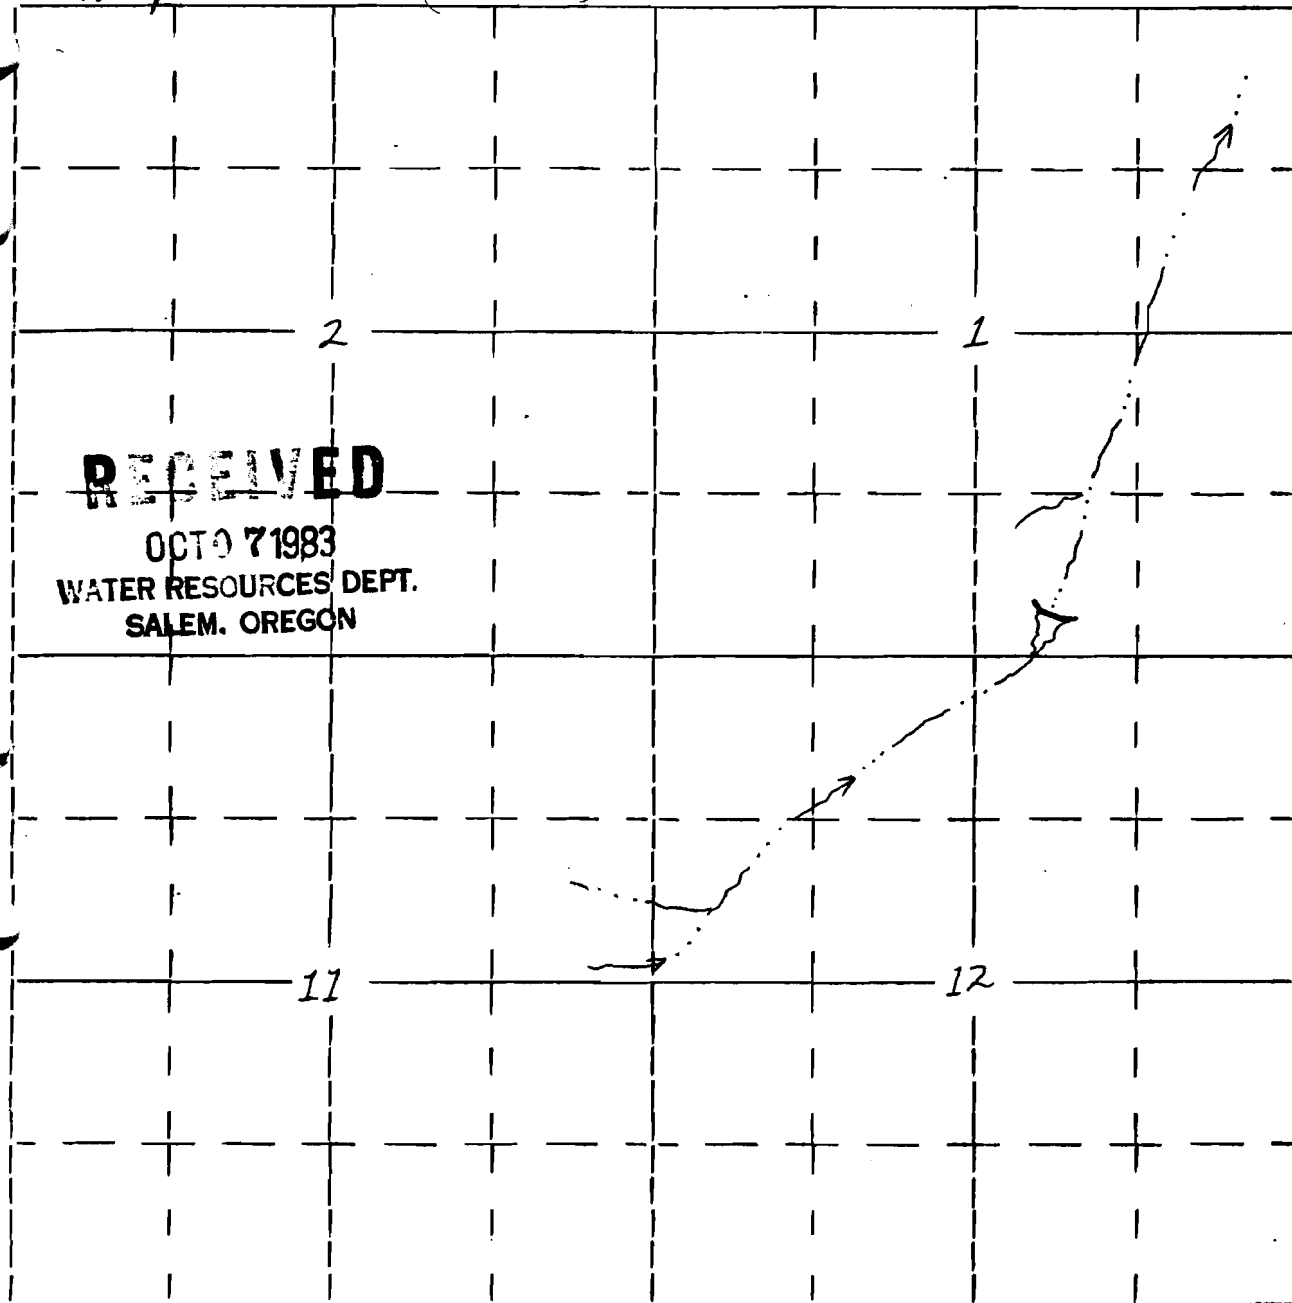

120' N., 1975' W. of SE corner of sec. 01