

Form OR-010-7300-2
4/83

UNITED STATES
DEPARTMENT OF THE INTERIOR
BUREAU OF LAND MANAGEMENT

Section

22

NWSW

Township 31 south

Range 28 east


Appl. No.

R67597

Permit No.

R 9462

central Dugout Reservoir #2 (#1298)

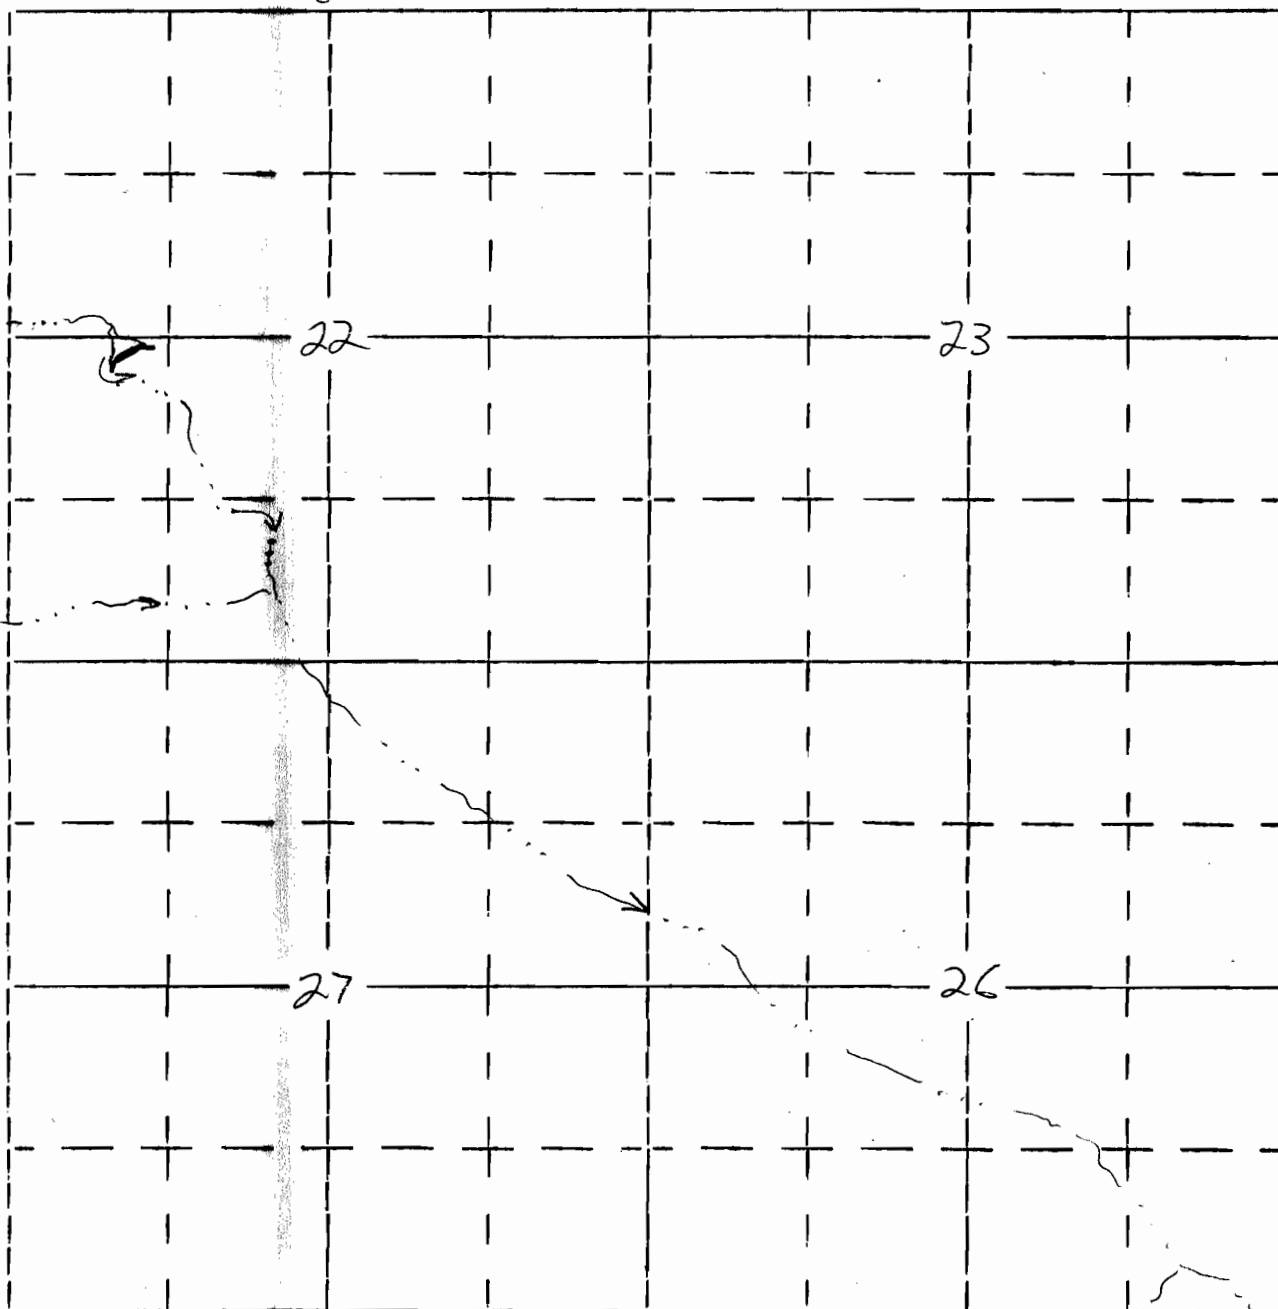

1300' N. , 990' E. of SW corner of section 22

BESE