

Form OR-010-7300-2  
4/83

UNITED STATES  
DEPARTMENT OF THE INTERIOR  
BUREAU OF LAND MANAGEMENT

Section

16

Township

30S

Appl. No.

R67601

SENE

Range


26E

Permit No.

R 9466

Will. Mer.

Road Waterhole 1323

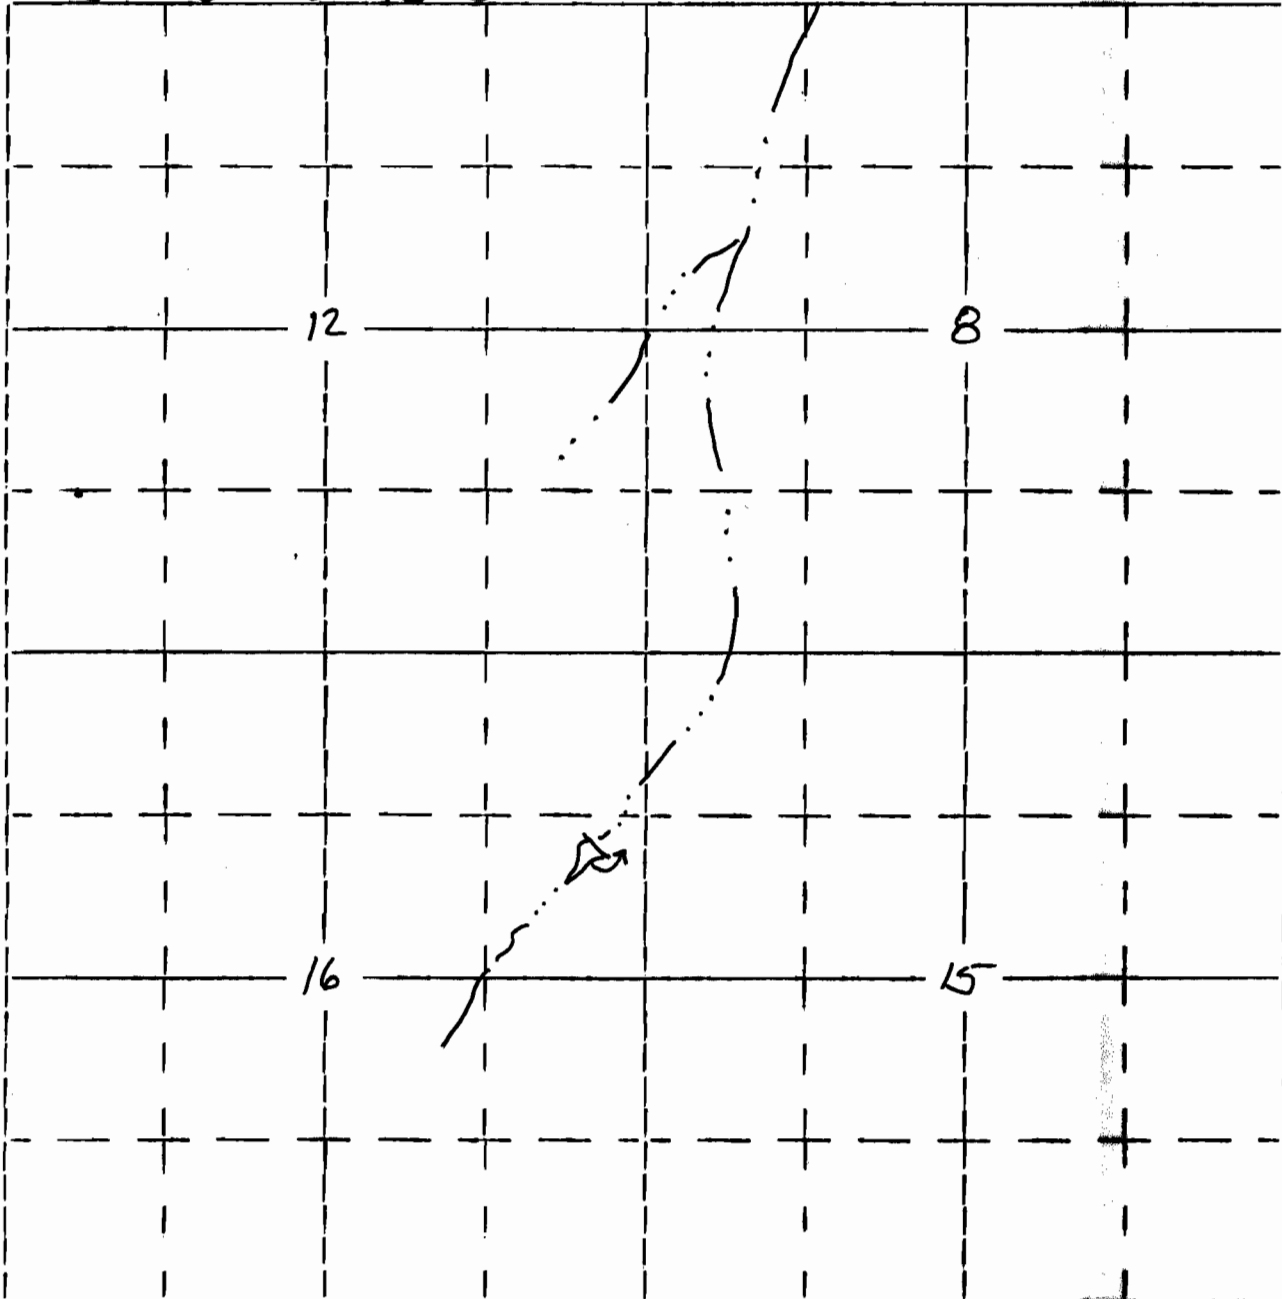

1500'S 600'W of the NE Corner of section 16