

Form OR-010-7300-2
4/83

UNITED STATES
DEPARTMENT OF THE INTERIOR
BUREAU OF LAND MANAGEMENT

Section 30
NW SW

Township 29S


Range 27E

Appl. No. R67605

Permit No. R 9469

Will. Mer.

Pop Eye Reservoir 1458

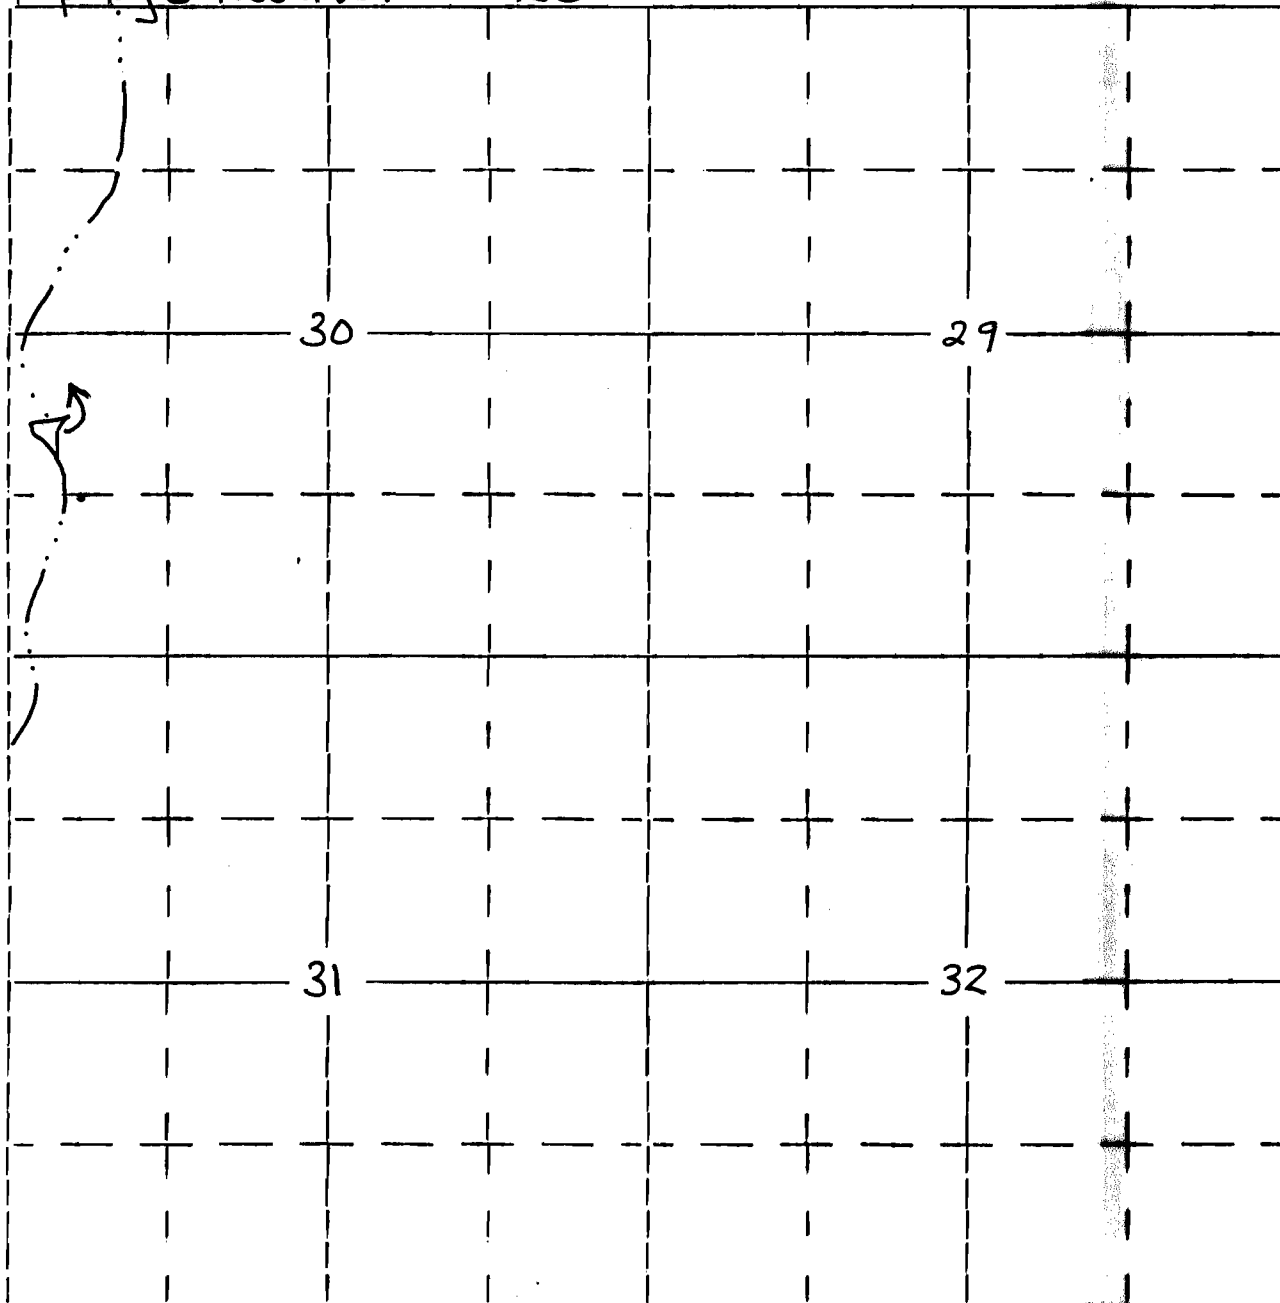

1800' N 500' E of the SW corner of section 30