

R9475
67499

Form OR-010-7300-2
4/83

UNITED STATES
DEPARTMENT OF THE INTERIOR
BUREAU OF LAND MANAGEMENT

Section

1

Township 39S

Appl. No. R67611


NW NW

Range 23E

Permit No. R 9475

Will. Mer.

Hortay Reservoir #1525

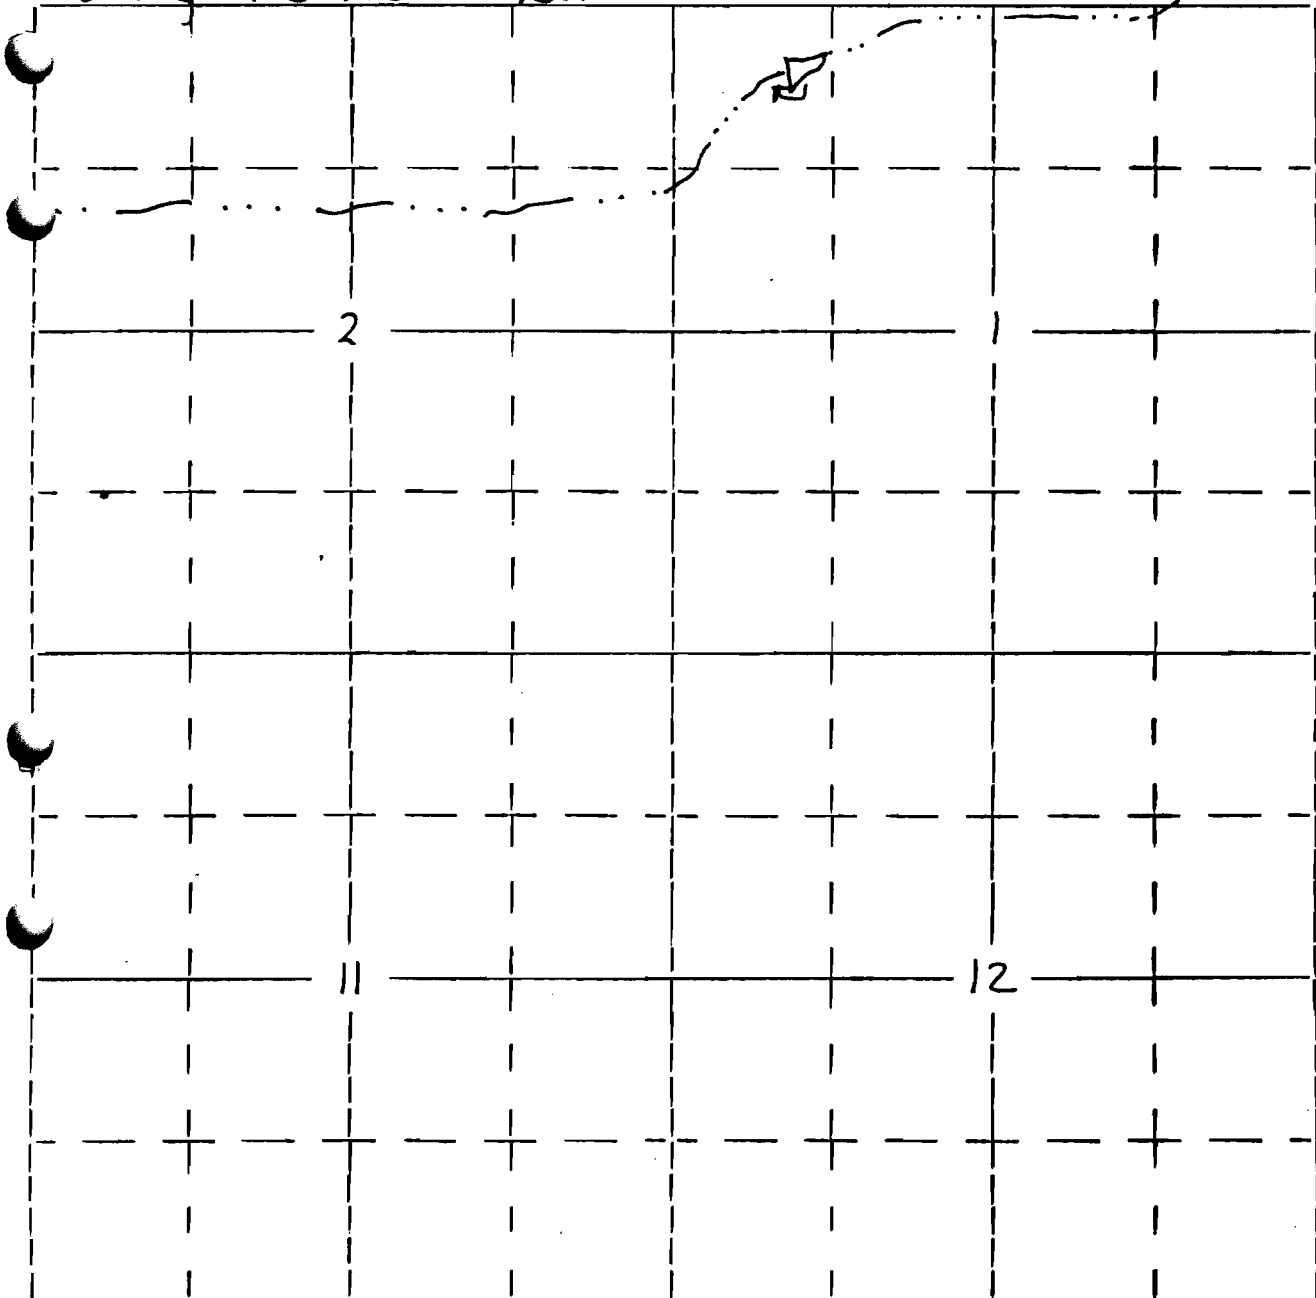

400'S 1200'E of the NW corner of section 1