

R10032
67500

Form OR-010-7300-2
4/83

UNITED STATES
DEPARTMENT OF THE INTERIOR
BUREAU OF LAND MANAGEMENT

Section 7

Township 29S

Appl. No. R67637

SWNW


Range 25E

Permit No. R10032

4"=1mi.

Will. Mer.

Cox Canyon Check 4232

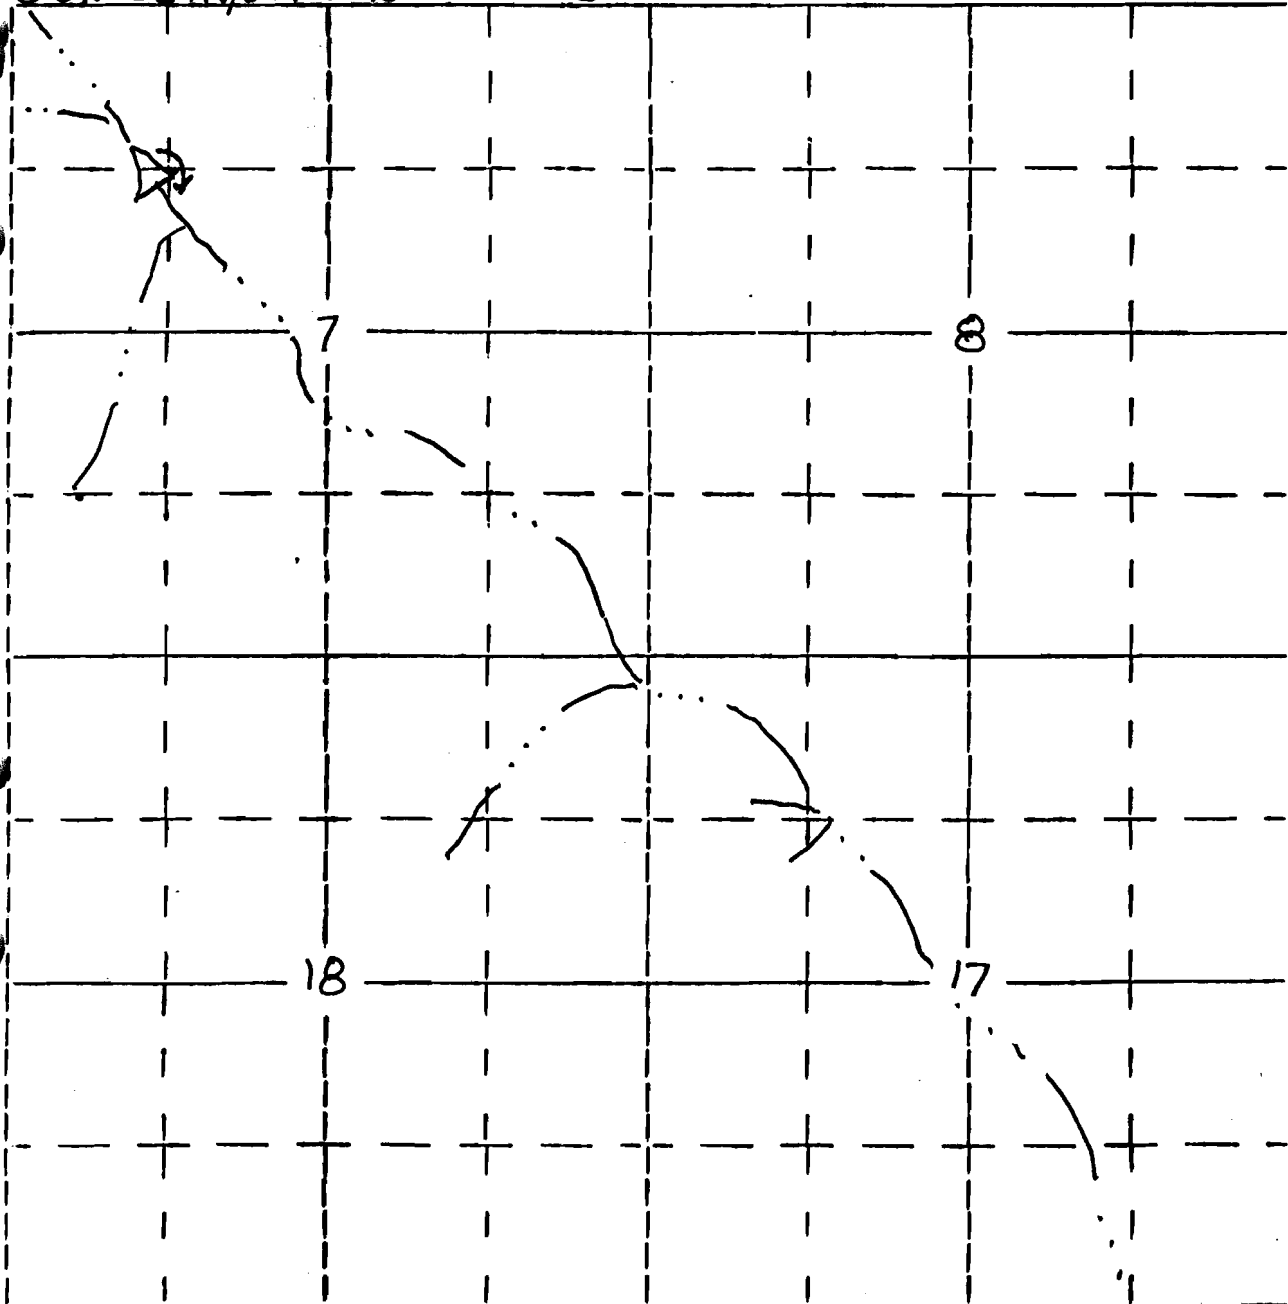

1500'S 1200' E of the NW corner of section

RECEIVED

OCT 13 1983

WATER RESOURCES DEPT.
SALEM, OREGON