

R-9502
67501

Form OR-010-7300-2
4/83

UNITED STATES
DEPARTMENT OF THE INTERIOR
BUREAU OF LAND MANAGEMENT


Section 5
SENE

Township 32S
Range 23E

Appl. No. R67643
Permit No. R 9502

Will. Mer.

Barefoot Reservoir #0552

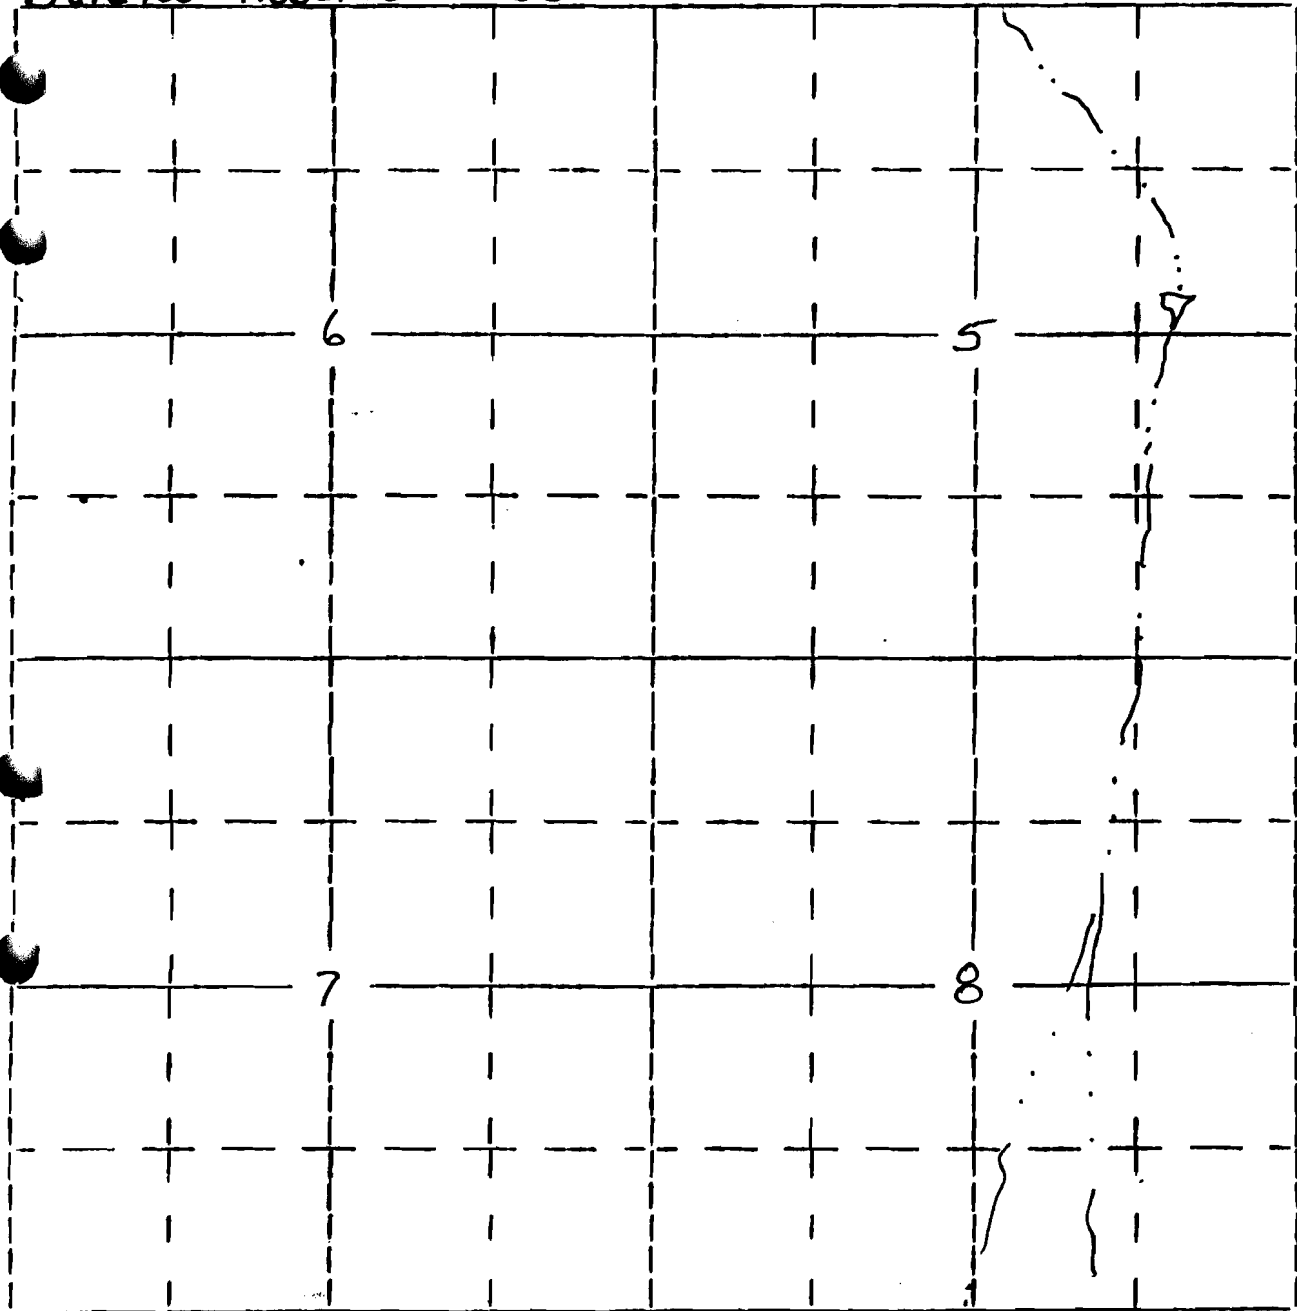

1500' S 950' W of NE corner of section 5