

Form OR-010-7300-2
4/83

UNITED STATES
DEPARTMENT OF THE INTERIOR
BUREAU OF LAND MANAGEMENT

Section

26

Township 29S

Appl. No. R67649


SE NW

Range 26E

Permit No. R 9507

Will. Mer.

Rexhide Reservoir #0947

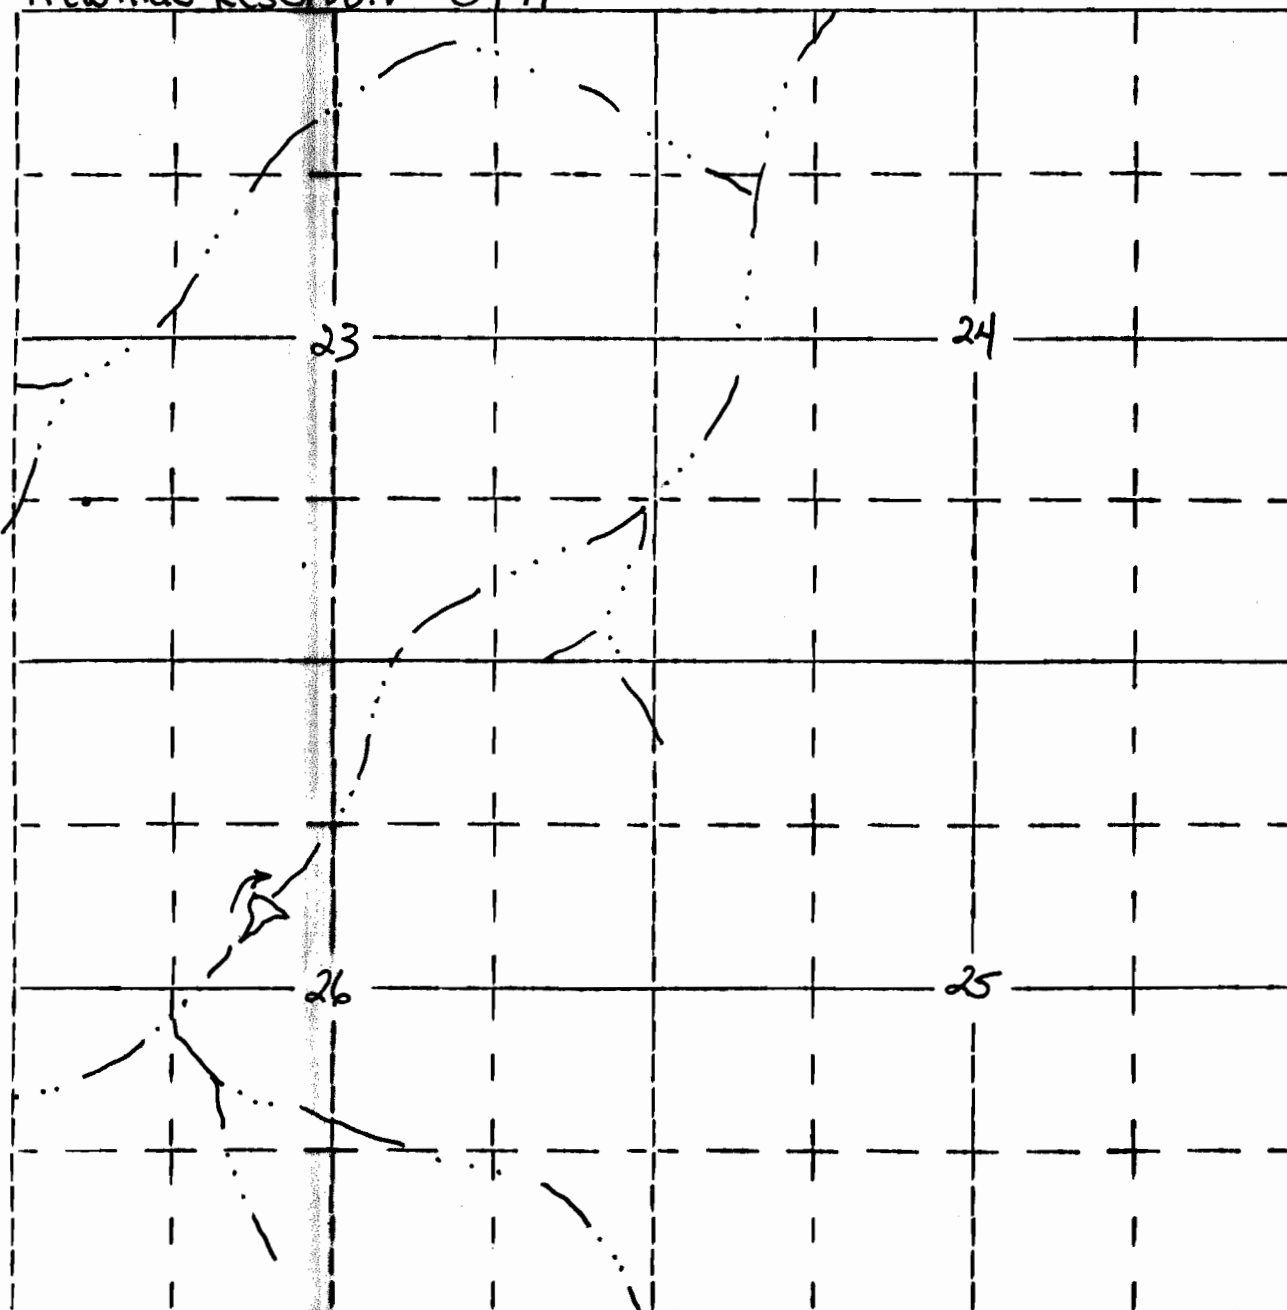

2,100'S 1,800'E of the NW corner of section 26

Beseta