

67504

Form OR-010-7300-2
4/83

UNITED STATES
DEPARTMENT OF THE INTERIOR
BUREAU OF LAND MANAGEMENT

Section 28

Township 32S

Appl. No. R67651


NENE

Range 25E

Permit No. R 9509

Will. Mer.

Alberts Reservoir #1266

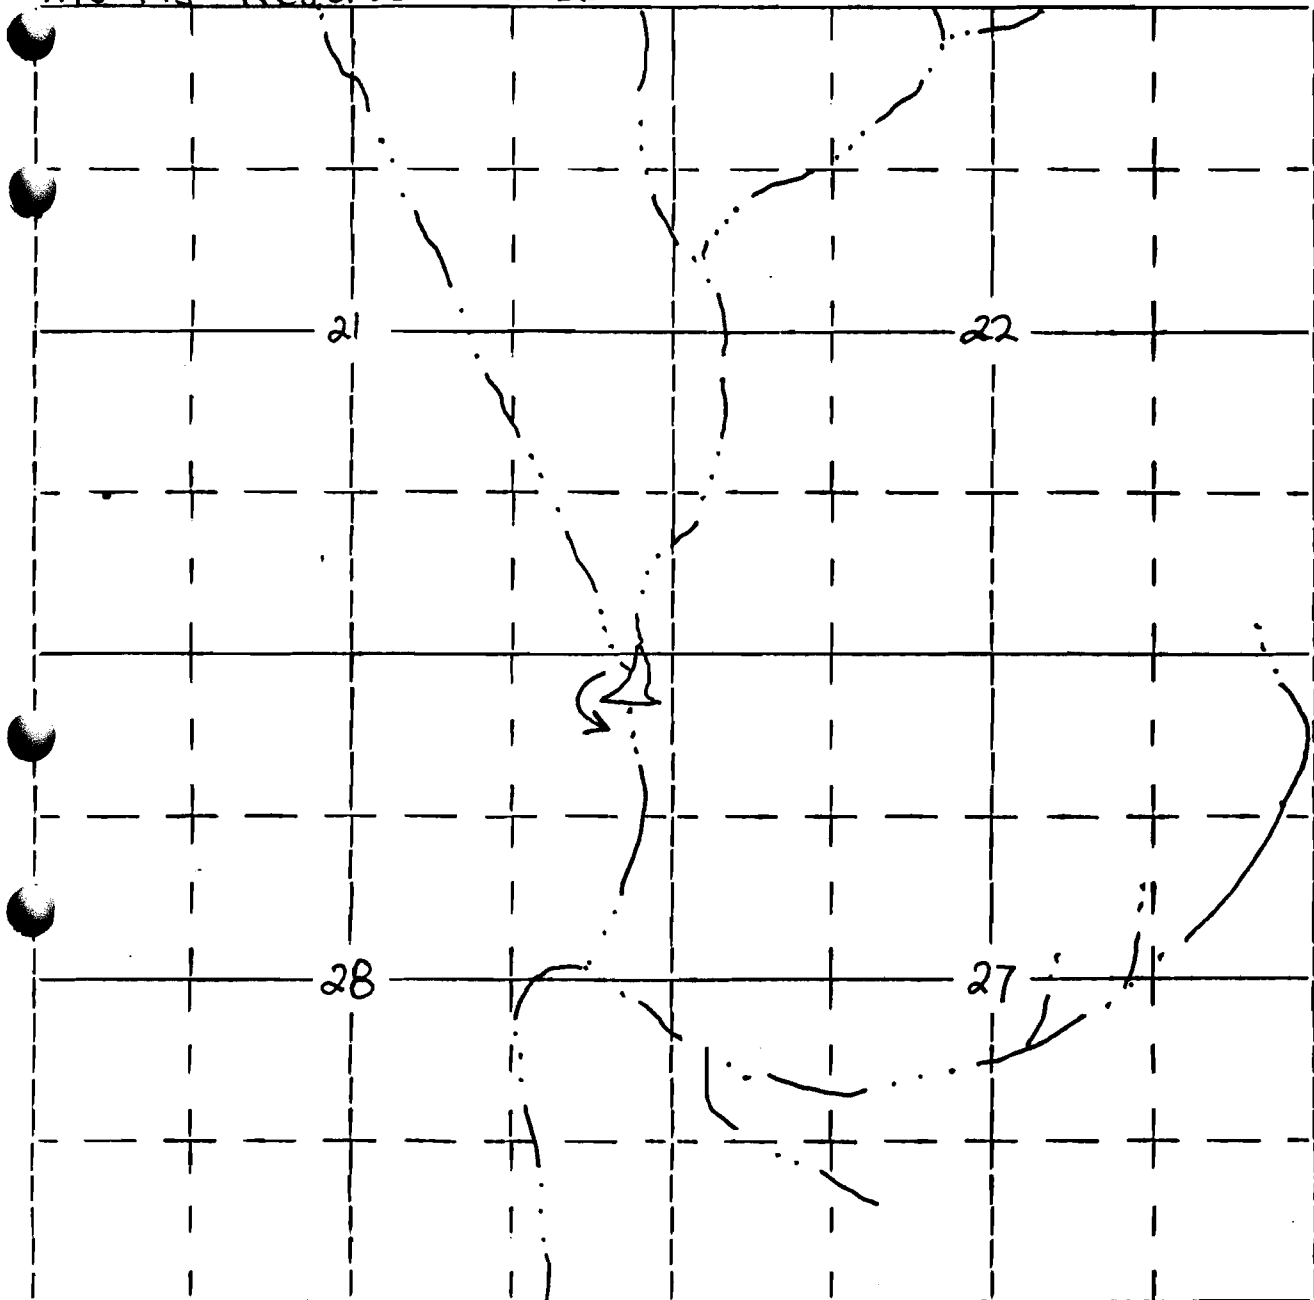

300'S 400'W of NE corner of section 28

10. 624