
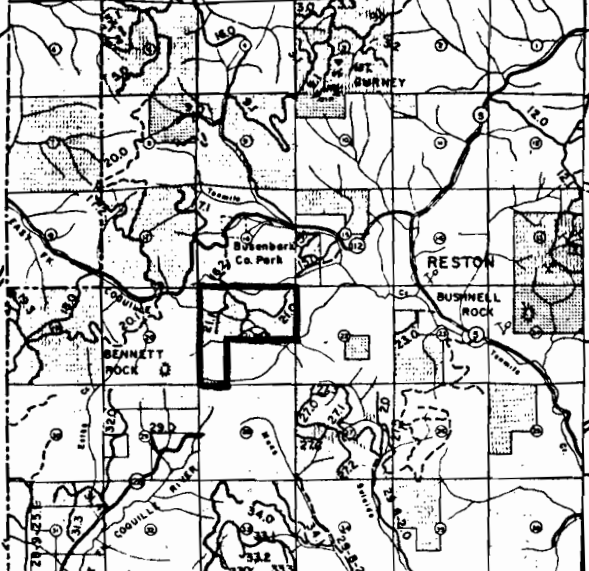


RECEIVED

JUL 20 1986

WATER RESOURCES DEPT.
SALEM, OREGON

Application No. R-68800, 68802
Permit No. R10882 50089

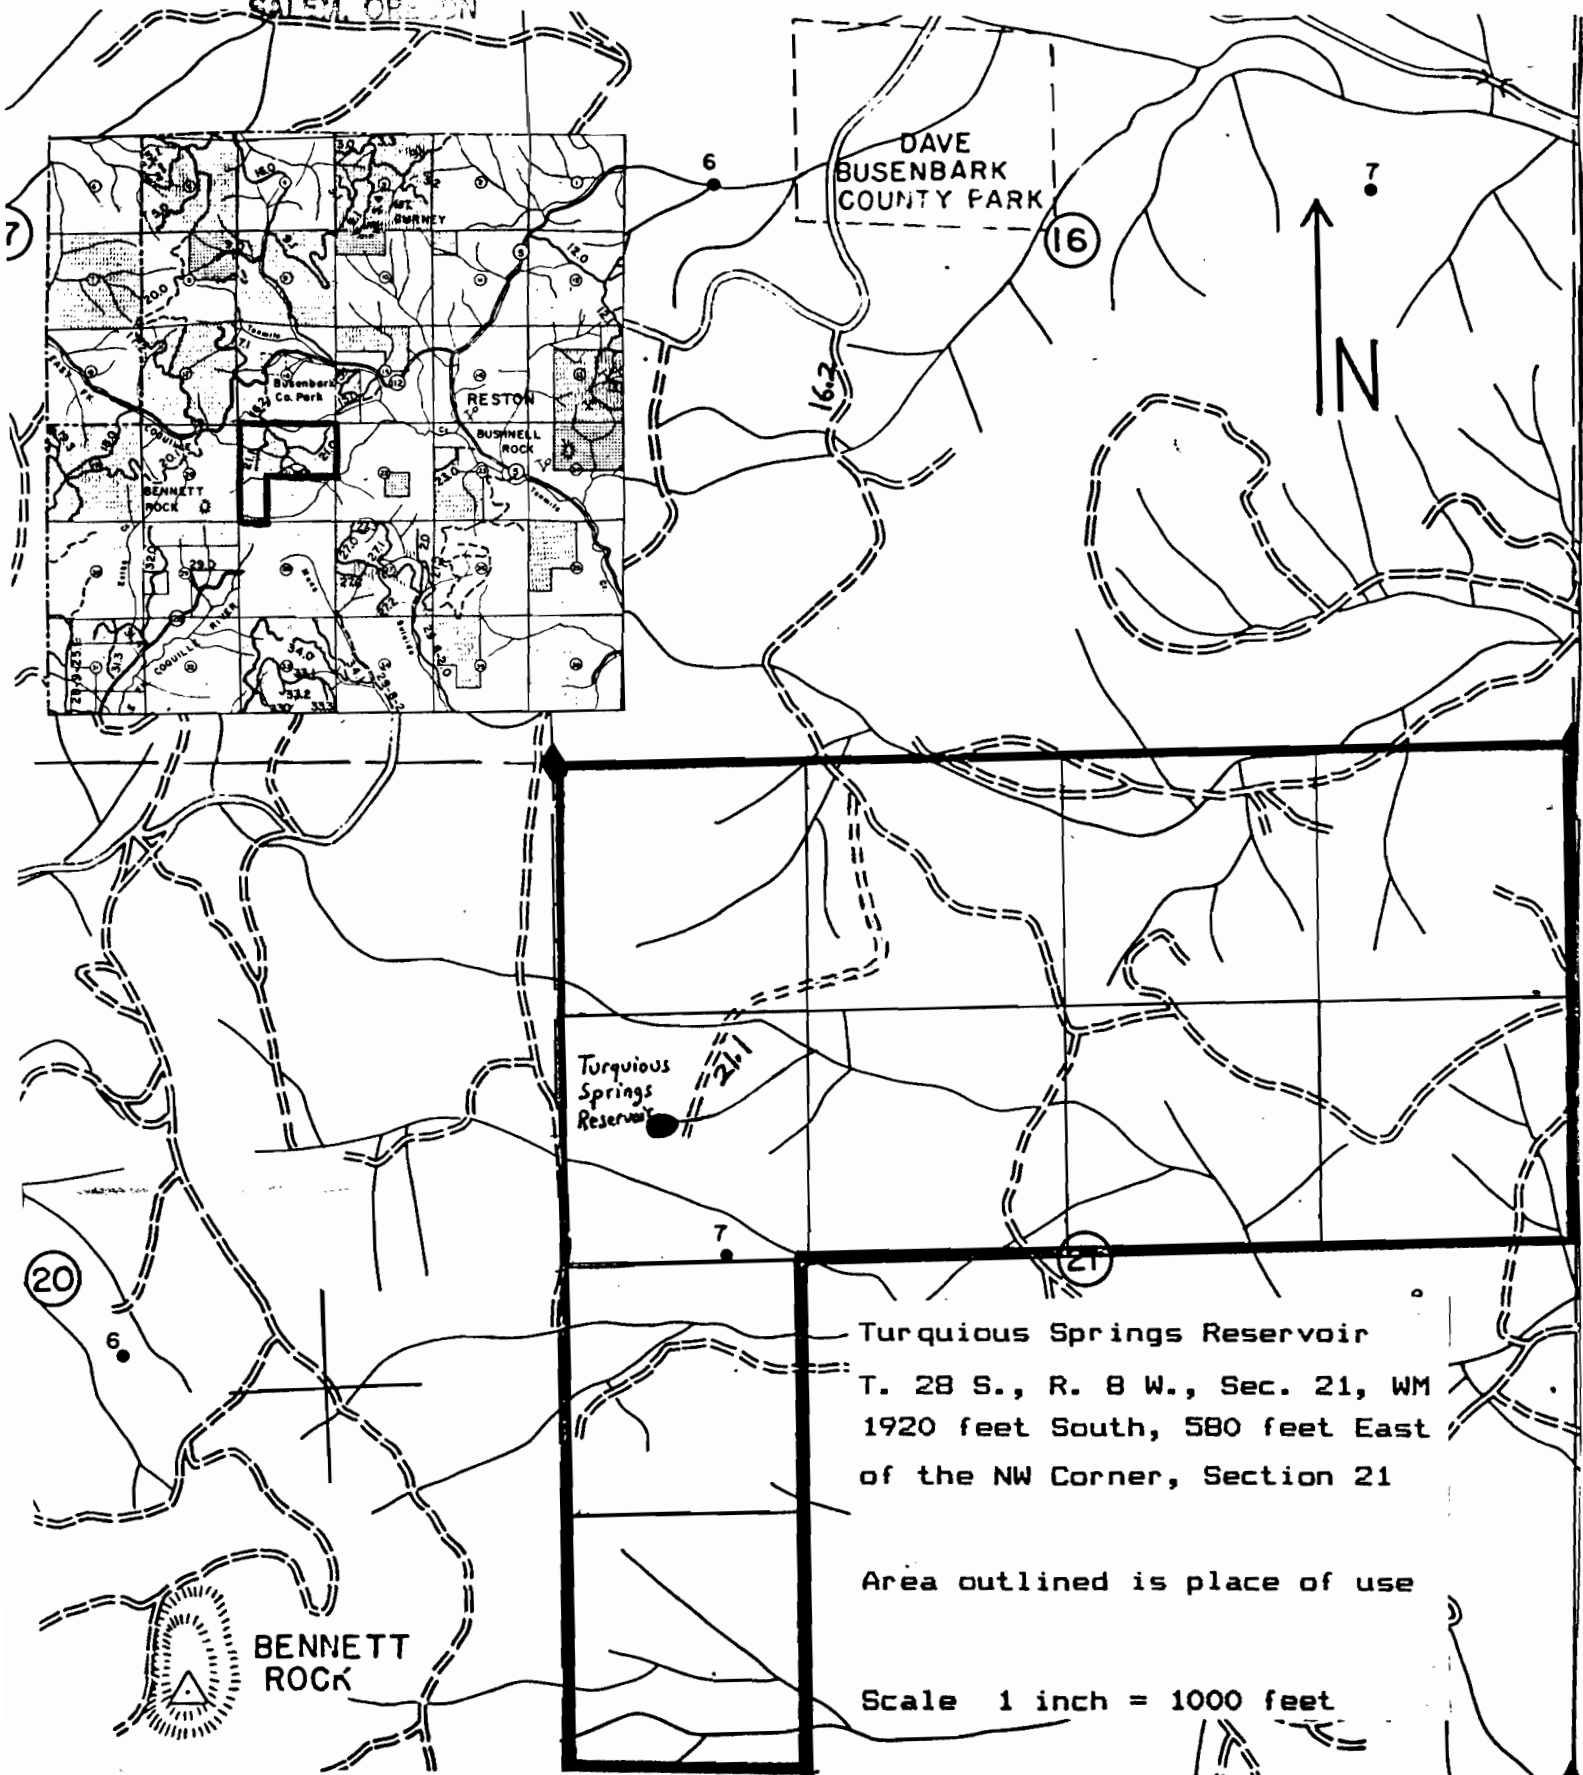

DAVE
BUSENBARK
COUNTY PARK

(16)

N
↑

Turquious
Springs
Reservoir

(20)

(21)

Turquious Springs Reservoir
T. 28 S., R. 8 W., Sec. 21, WM
1920 feet South, 580 feet East
of the NW Corner, Section 21

Area outlined is place of use

BENNETT
ROCK

Scale 1 inch = 1000 feet