


T26S. R6W.WM

SCALE 1" = 1320'

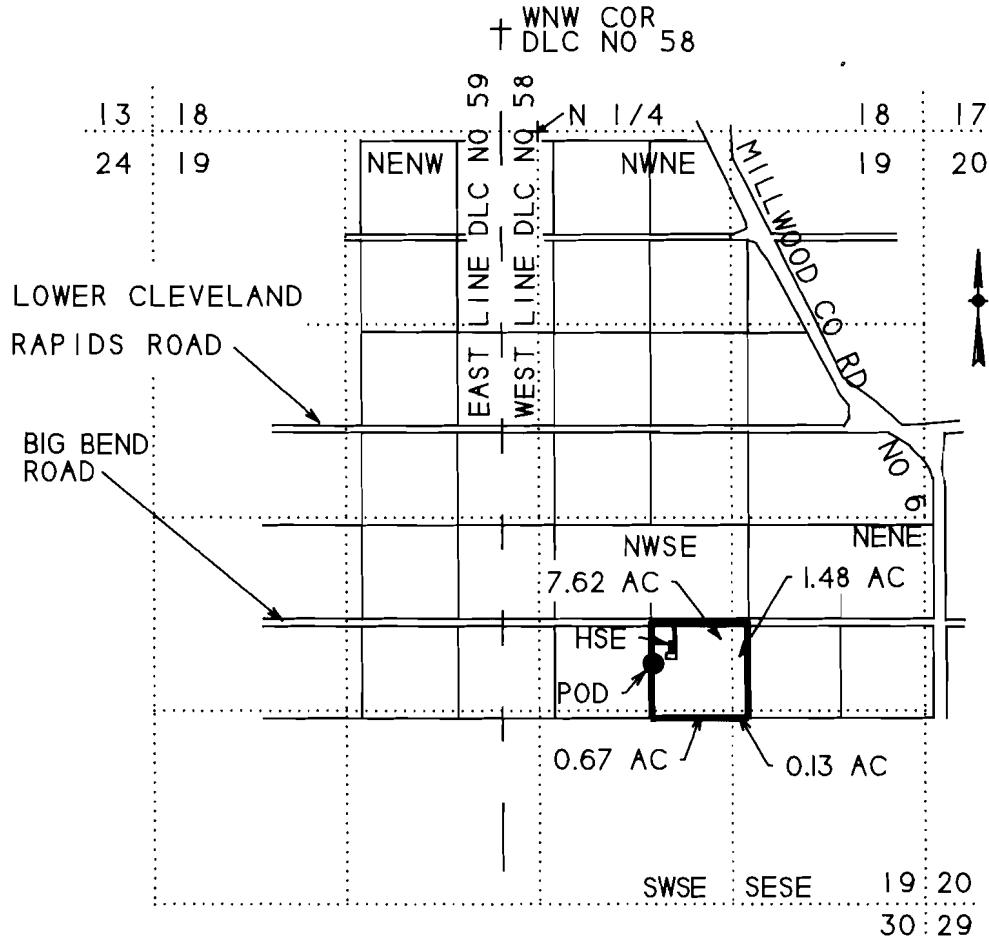

POD IS 1650 FT N AND 1860 FT W FROM SE COR SEC 19

FINAL PROOF SURVEY


UNDER

Application No. G-12098 Permit No. G-11143

IN NAME OF


VERNON E RICHARDSON

Surveyed October 14, 1991 by M E Farr

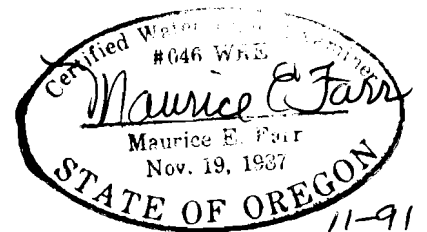

T26S. R6W. WM

SCALE 1" = 1320'

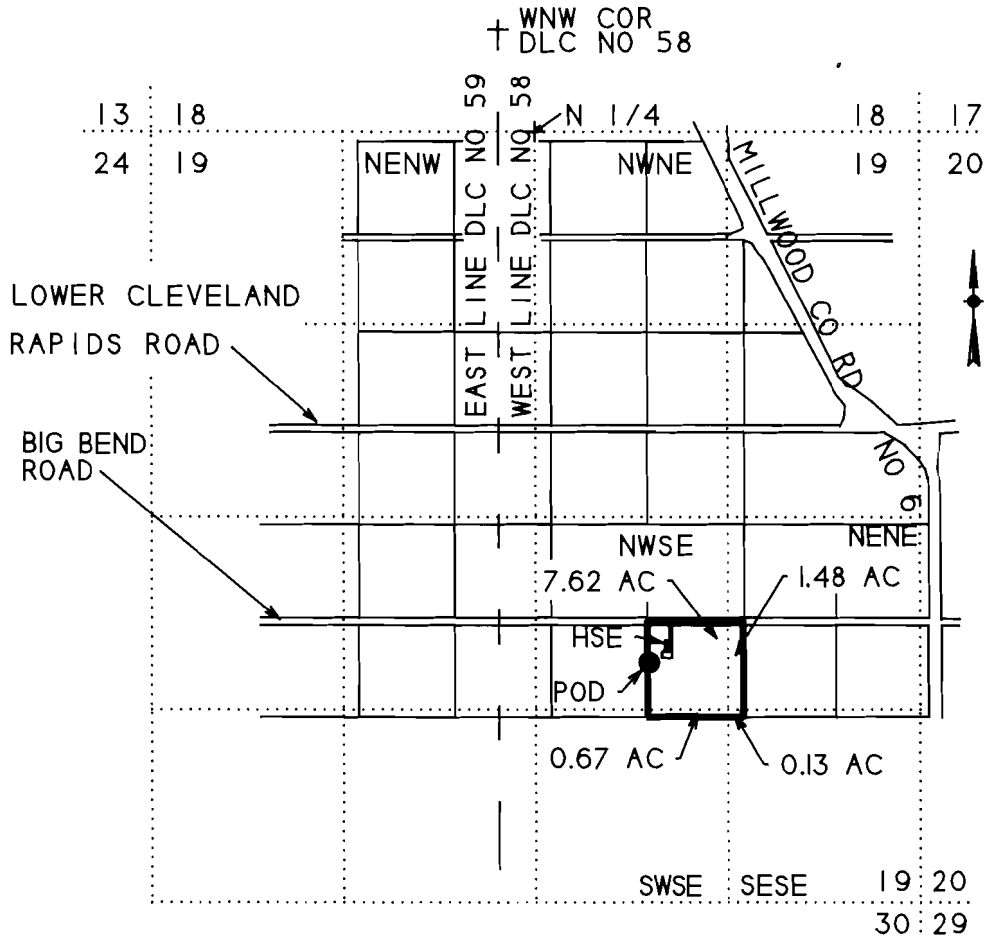

POD IS 1650 FT N AND 1860 FT W FROM SE COR SEC 19

FINAL PROOF SURVEY

UNDER

Application No. G-12098 Permit No. G-11143

IN NAME OF

VERNON E RICHARDSON

Surveyed October 14, 1991 by M E Farr

