


T.40S., R.8W., W.M.

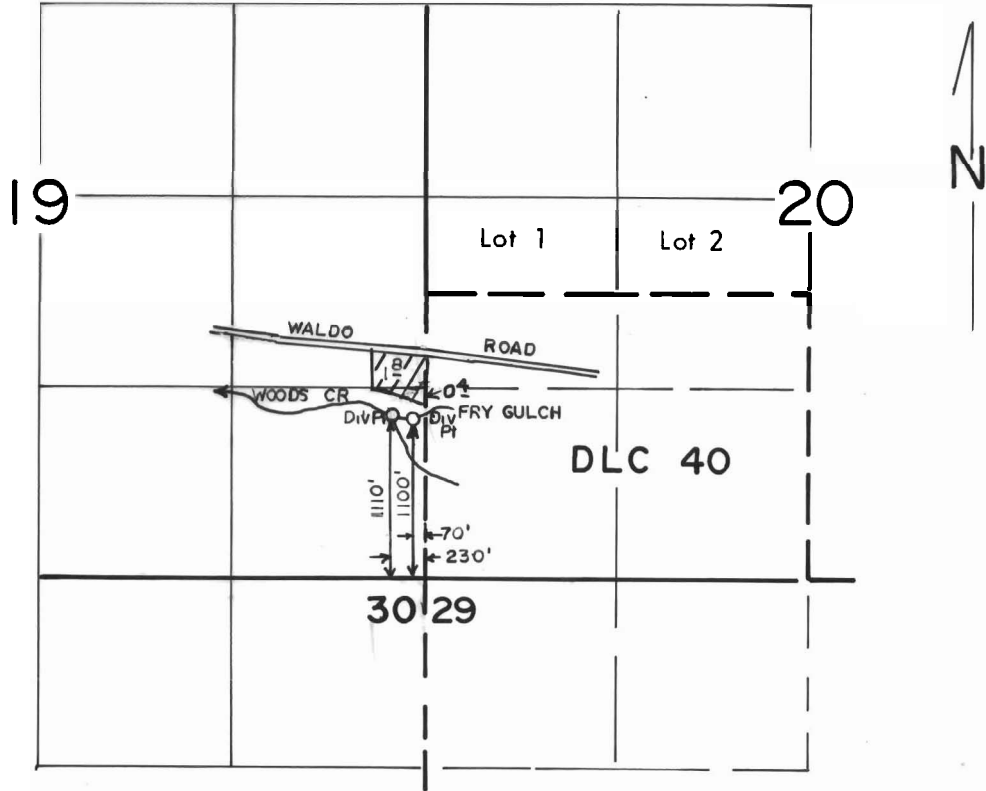

SCALE: 1" = 1320'

FINAL PROOF SURVEY
UNDER

Application No. 57586... Permit No. 43354.....
IN NAME OF

.....**TERRY & MARY WELCH**.....

Surveyed MAR...26... 19.84., by B.S. JAMES.....