


# T.26S., R.4W. W.M.

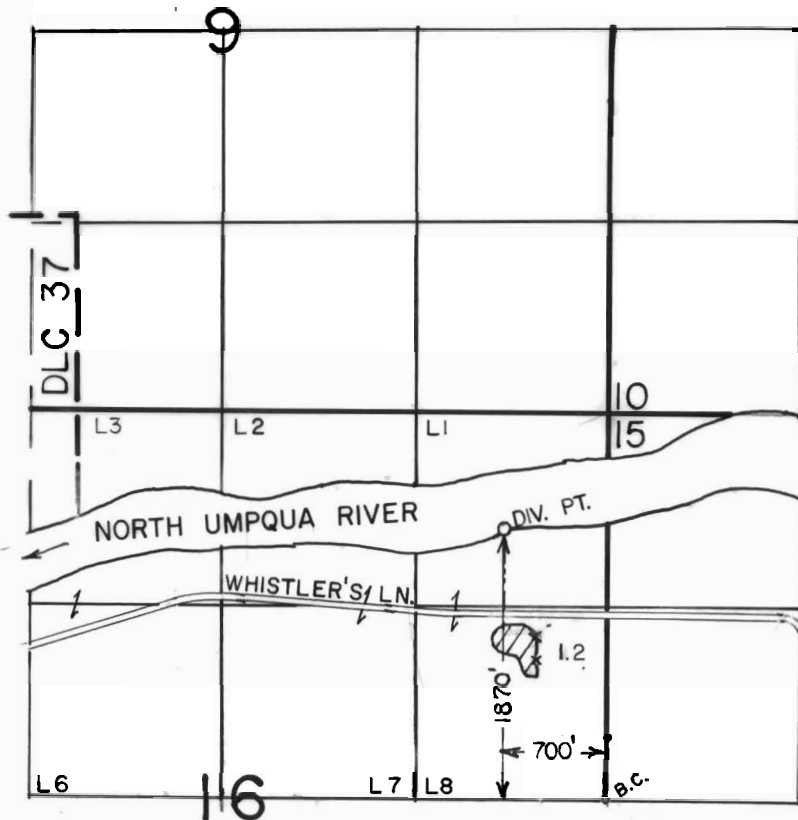

## FINAL PROOF SURVEY UNDER

Application No. 59420... Permit No. 44701.....  
IN NAME OF

.....VIRGIL J. HELMKE.....

Surveyed SEP...3.... 1986., by J.M. SCHMORDE...