46244
67518

T.36S., R.7E., W.M.

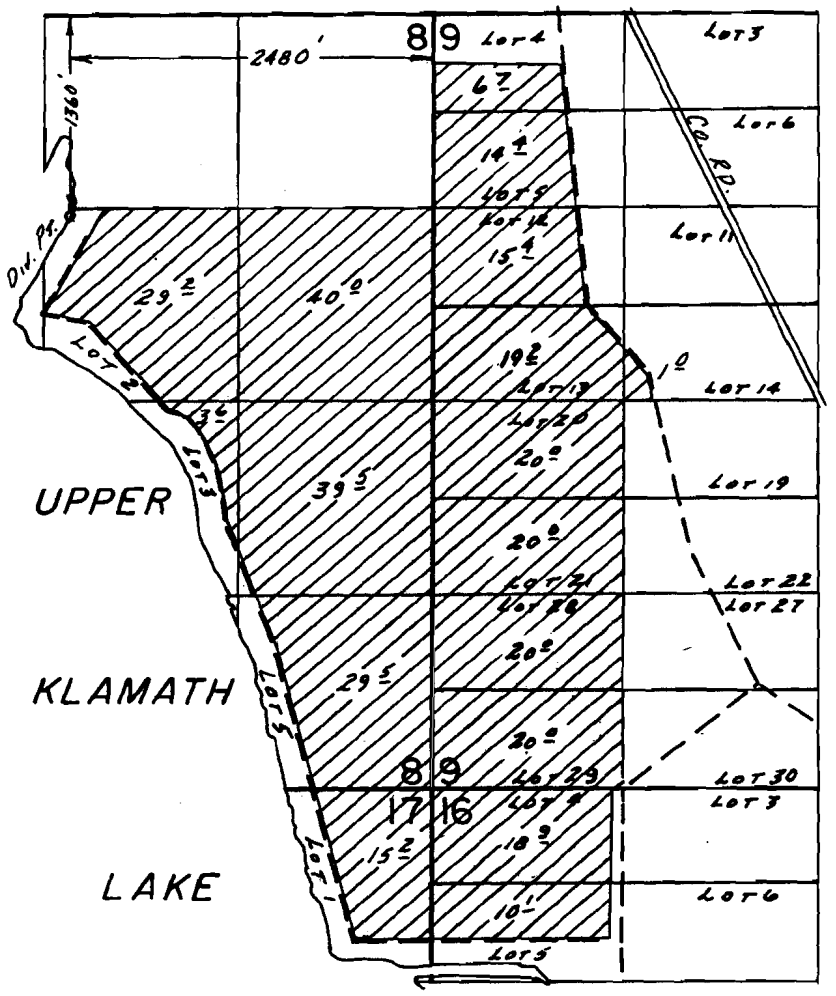

SCALE: 1" = 1320'

FINAL PROOF SURVEY

UNDER

Application No. 61825 Permit No. 46244

IN NAME OF

GOOSE BAY FARMS

Surveyed May 26, 1988, by B.W. BISHOP

Upper Klamath Lake, Oreg.

1/24/89 BWB
41035-178-2072