


T. 29 S., R. 7 W., W. M.

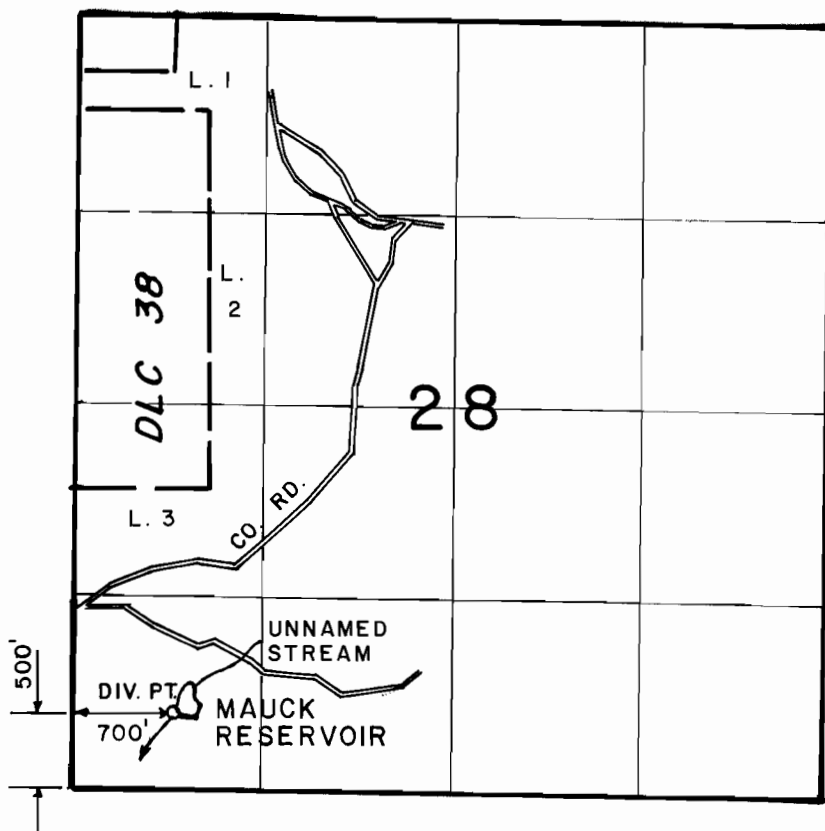

SCALE: 4" = 1 MILE

FINAL PROOF SURVEY
UNDER

Application No. R-63557. Permit No. R-8459.....
IN NAME OF

EVERETT F. MAUCK

Surveyed JULY 16, 1987, by J. M. SCHMORDE