


W1/2 NE 1/4 SEC. 4, T. 32 S., R. 3 W., W.M.

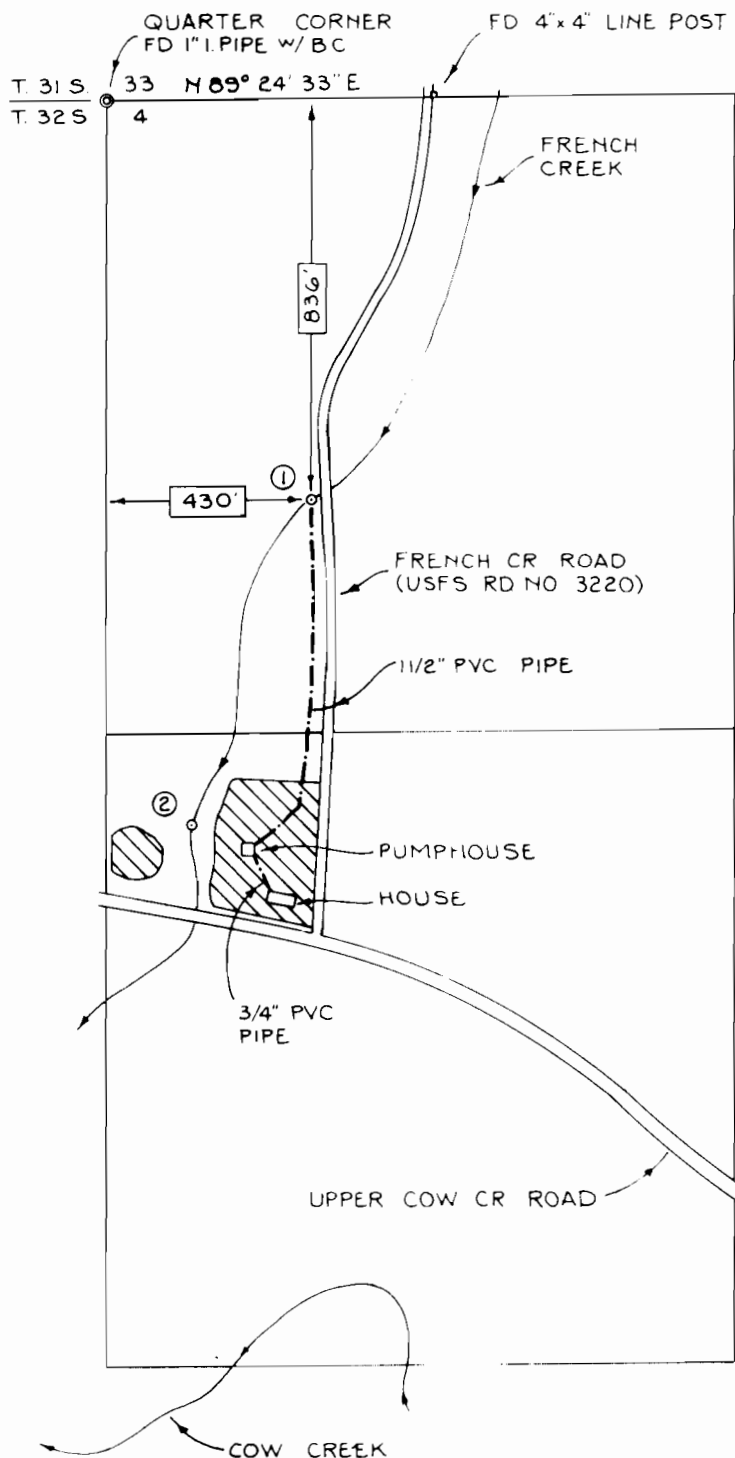


LEGEND:

o POINT OF DIVERSION

① DOMESTIC USE PER PERMIT NO. 50129

② IRRIGATION AS SHOWN ON THE FINAL PROOF SURVEY MAP PREPARED BY JS DONALDSON ON JULY 15, 1980 FOR PERMIT NO 40874 (1500'S & 170'E. OF 1/4 COR.)

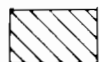 AUTHORIZED PLACE OF BENEFICIAL USE PER PERMIT NO 40874 AS SHOWN ON THE MAP DESCRIBED ABOVE. (15 ACRES TOTAL)

--- PIPE LINE

THE TIES TO DIVERSION PT NO 1 ARE BASED UPON A RECORD BEARING OF N 89° 24' 33" E FOR THE N LINE OF SEC 4 AS SHOWN ON A NATIONAL FOREST BOUNDARY LINE POST.

SCALE:
1" = 400'

THE SURVEY TIES WERE MADE BY TRAVERSE USING A WILD T-16ED THEODOLITE AND A GEODIMETER /AGA 12 EDM

THIS PLAT WAS PREPARED FOR THE PURPOSE OF IDENTIFYING THE LOCATION OF THE WATER RIGHT ONLY. THERE IS NO INTENT TO PROVIDE DIMENSIONS OR LOCATIONS OF PROPERTY OWNERSHIP LINES.


A THREE PAGE SITE REPORT ACCOMPANIES THIS PLAT

PROJECT NO
75-89-66

DRAWING NO
13-8.5.11

DATE
3-8-89

SCALE
1" = 400'

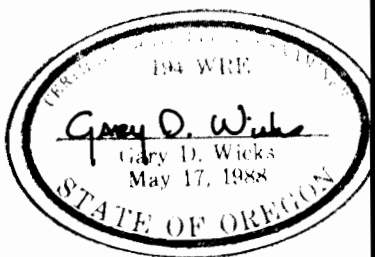

PLAT OF CLAIM OF BENEFICIAL USE LOCATED IN W1/2 NE 1/4 SEC. 4, T. 32 S., R. 3 W., W.M. DOUGLAS COUNTY, OREGON

PREPARED FOR:

JANET LEVINSON & RICHARD BARNES
BOX 58
COW CREEK ROAD
AZALEA, OREGON 97410
TEL 857-3504

PREPARED BY:

GARY D. WICKS, PE, PLS
962 SE "H" STREET
GRANTS PASS, OREGON 97526-3250
TEL 479-3436