


T28S. R5W.WM

SCALE 1" = 1320'

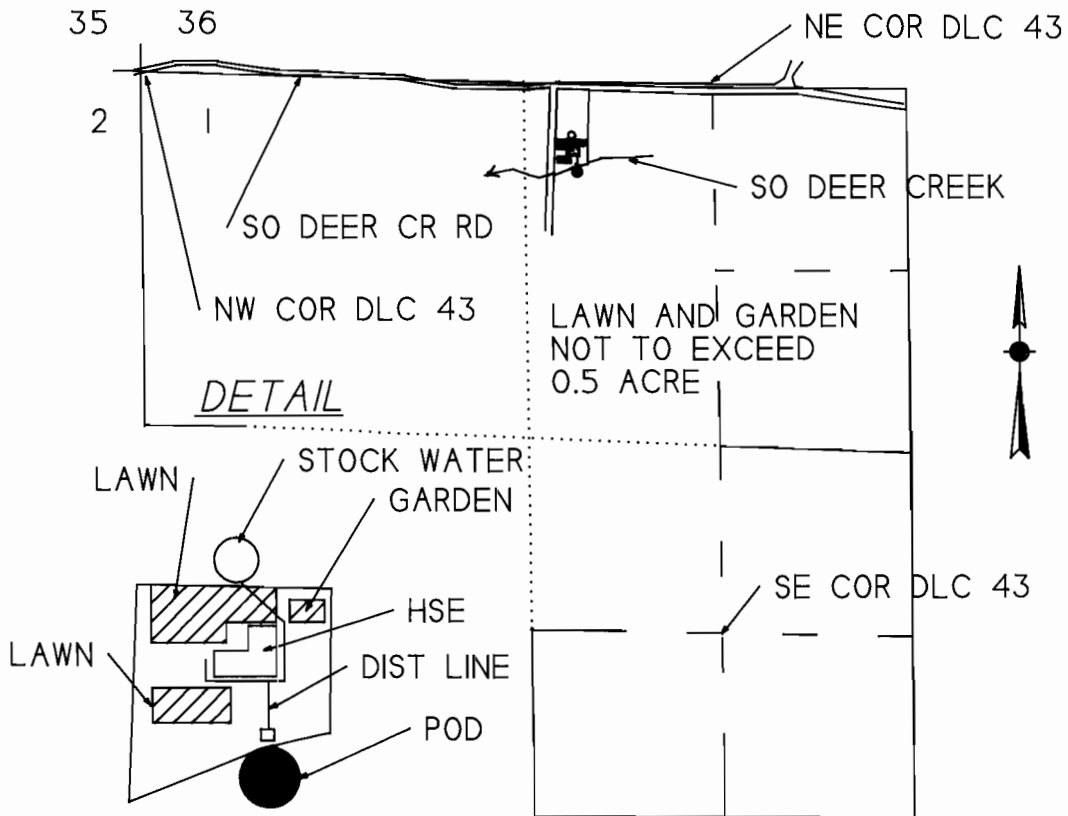

POD IS 650 FT S AND 3000 FT E FROM NW COR SEC 1

# FINAL PROOF SURVEY

UNDER

Application No. 69225 Permit No. 50145

IN NAME OF

RICHARD K OR LILLIAN J LUNDSTEN

Surveyed May 11, 1991 by M E Farr

