

27


26

34

35



SEC 35 T7S R5W W.M.
POLK COUNTY

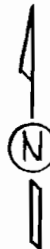

SCALE: 1"=400'

PREPARATION OF THIS MAP IS FOR THE
PURPOSE OF IDENTIFYING THE LOCATION OF
THE WATER RIGHT ONLY. THERE IS NO INTENT
TO PROVIDE DIMENSIONS OR LOCATION OF
PROPERTY OWNERSHIP LINES.

FINAL PROOF SURVEY
PERMITS 50184 AND R10894
SURVEYED NOV. 22, 1991


6
5984

FRONT

SEC 06 1SS

WATER RESOURCES DEP.
SALEM, OREGON

PIPE LINE

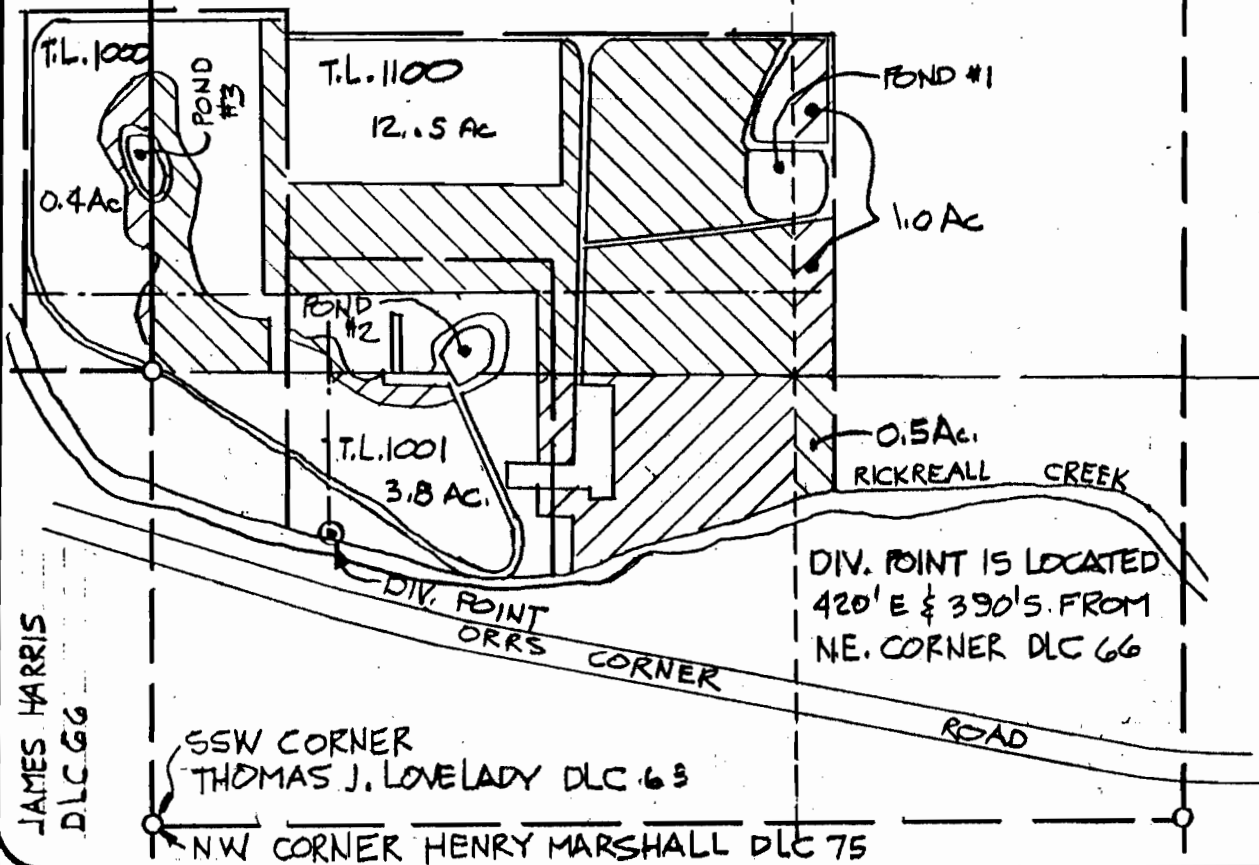

VERBOORT ENGINEERING
AGRICULTURE-CIVIL-WATER RESOURCES
HILLSBORO, OREGON

designed	WRV	12-91
drawn	JER	12-91
checked	WRV	12-91
drawing no.	91-A-21	
sheet no.	1/1	

LINCOLN HORIZON, INC.
DALLAS, OR