


T. 29S. . R. 11W. . W. M.

EXAMINERS DISCLAIMER STATEMENT

THE PREPARATION OF THIS MAP WAS FOR THE PURPOSE OF IDENTIFYING THE LOCATION OF THE WATER RIGHT ONLY AND HAS NO INTENT TO PROVIDE DIMENSIONS OR LOCATION OF PROPERTY OWNERSHIP LINES.

CENTER 1/4 COR
SECTION 28

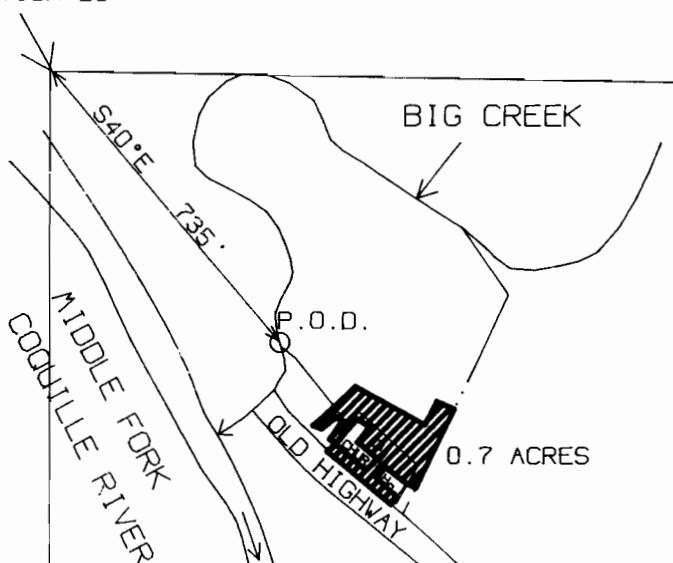

SCALE 1" = 400'

Harvey Wilcox

FINAL PROOF SURVEY

Application No. 69328... Permit No. .50591....

IN NAME OF

.....BRIDGE COMMUNITY CHURCH.....

Surveyed .AUG 6..... 1990... by .H.A. WILCOX