

RECEIVED

IFB 28 1990

WATER RESOURCES DEPT
SALEM, OREGON

FINAL PROOF SURVEY MAP

IN THE NAME OF JACK A. HAGEN


SECTION 36, T31S, R4W, W. M.

APPLICATION 69395

PERMIT 50176



1 INCH = 1320 FEET

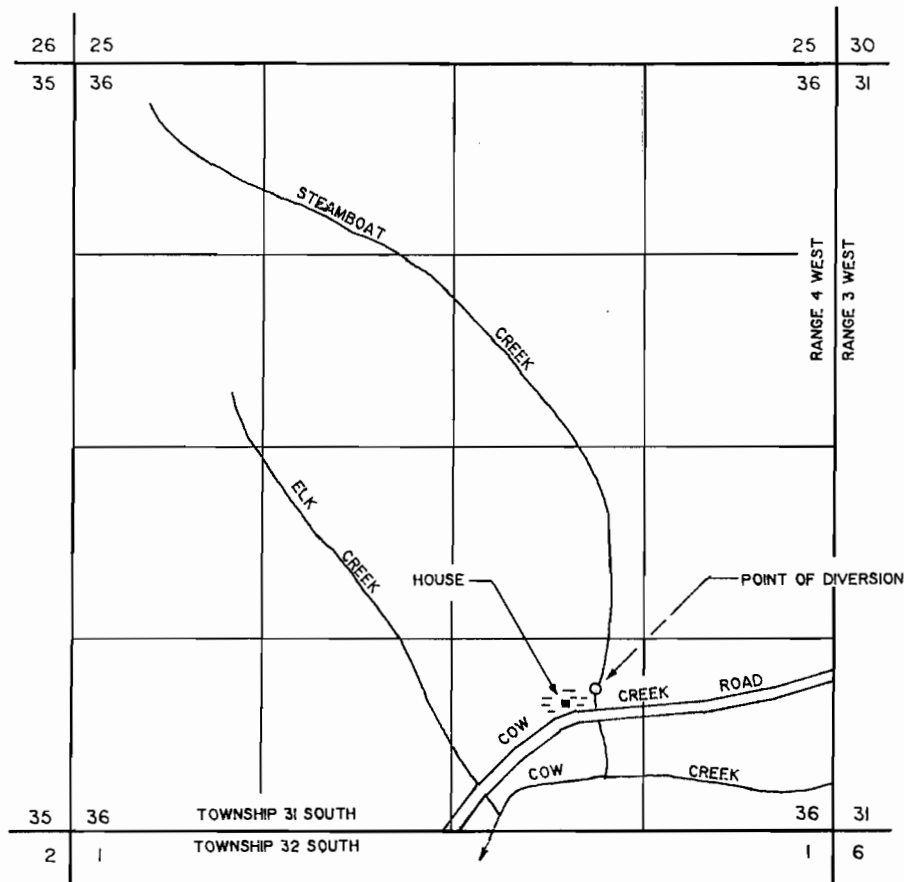

THE POINT OF DIVERSION IS LOCATED 950 FEET NORTH AND 1640 FEET WEST FROM THE SOUTHEAST CORNER OF SECTION 36, BEING WITHIN THE SW1/4 SE1/4 OF SECTION 36, TOWNSHIP 31 SOUTH, RANGE 4 WEST, W. M.

THE PURPOSE OF THIS MAP IS TO IDENTIFY THE LOCATION OF THE WATER RIGHT. IT IS NOT INTENDED TO PROVIDE INFORMATION RELATIVE TO THE LOCATION OF PROPERTY OWNERSHIP BOUNDARY LINES.

