


SECTION 32 T.5S., R.2E., W.M.
CLACKAMAS COUNTY

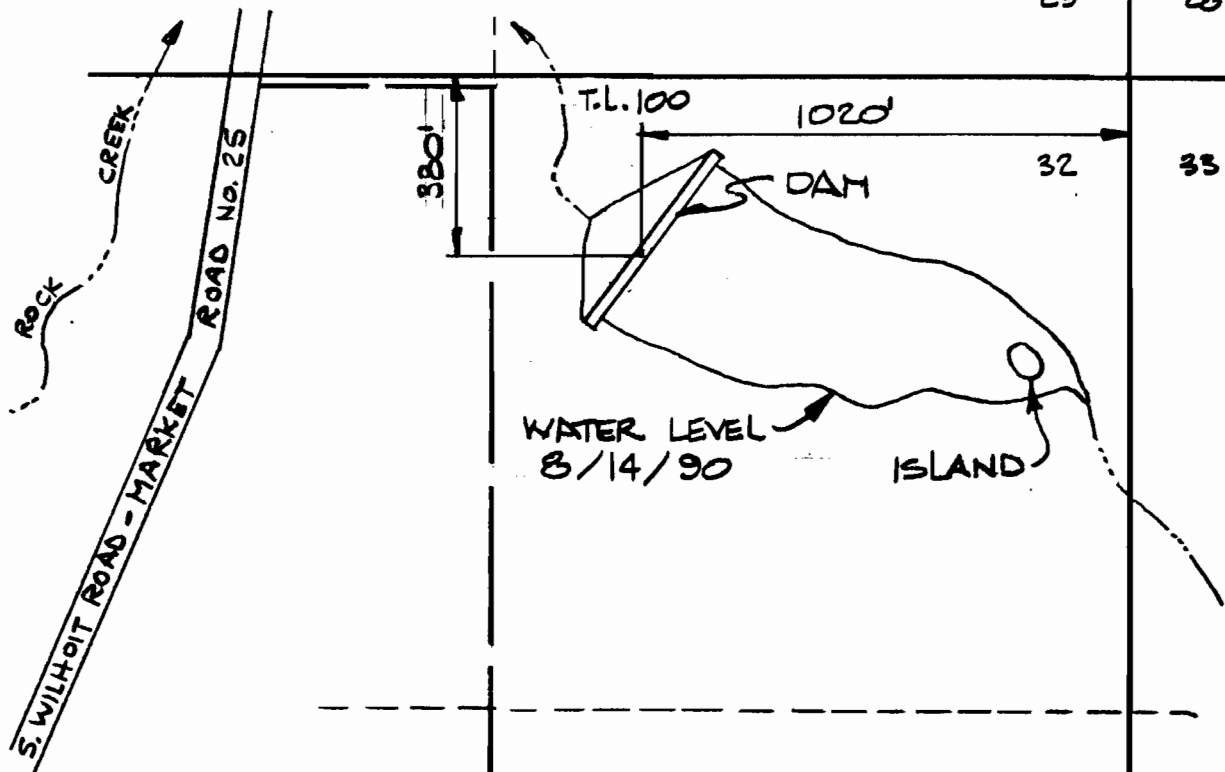

PREPARATION OF THIS MAP IS FOR THE
PURPOSE OF IDENTIFYING THE LOCATION OF
THE WATER RIGHT ONLY. THERE IS NO INTENT
TO PROVIDE DIMENSIONS OR LOCATION OF
PROPERTY OWNERSHIP LINES.

FINAL PROOF SURVEY
UNDER
PERMIT NO. R-10895
SURVEYED 8/6/91

VERBOORT ENGINEERING
AGRICULTURE • CIVIL • WATER RESOURCES
HILLSBORO, OREGON

designed by date
WRV 8/91
drawn JER 8/91
checked WRV 8/91
drawing no. 91-A-13
sheet no. 1/1

HARVEY W. BUCHE
35111 S. WILHOIT ROAD
MOLALLA, OR 97038