


T. 40S., R. 14W., W.M., N.E. 1/4 SEC. 10

FINAL PROOF SURVEY

APPLICATION NO. 69476 PERMIT NO. 50430IN THE NAME OF: RICHARD O. MILLER

SURVEYED JULY 28, 1989, BY THOMAS J. HOWIE, CWRE 070

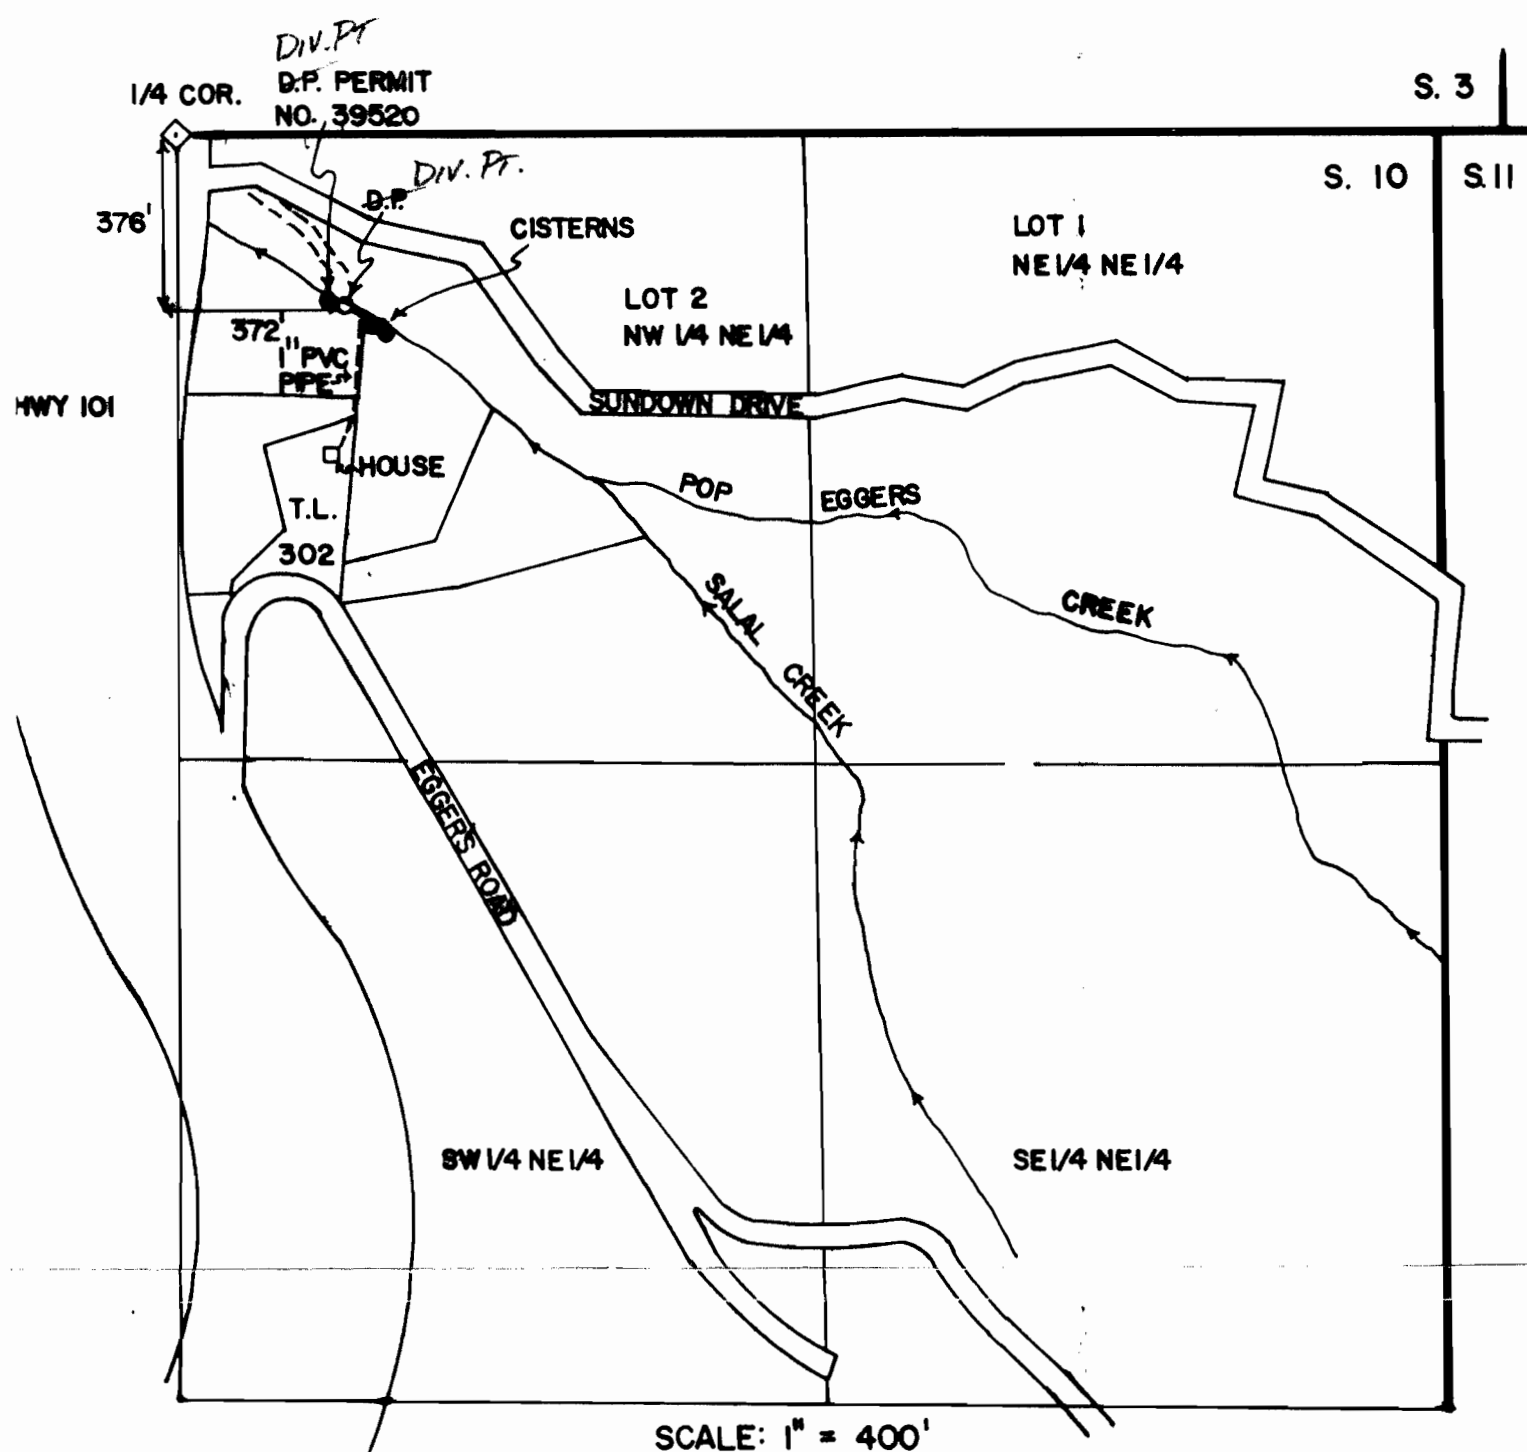

MAP SHOWS THE LOCATION OF A WATER RIGHT
AND HAS NO INTENTION TO PROVIDE DIMENSIONS
OR LOCATION OF PROPERTY OWNERSHIP LINES.

SCALE

