


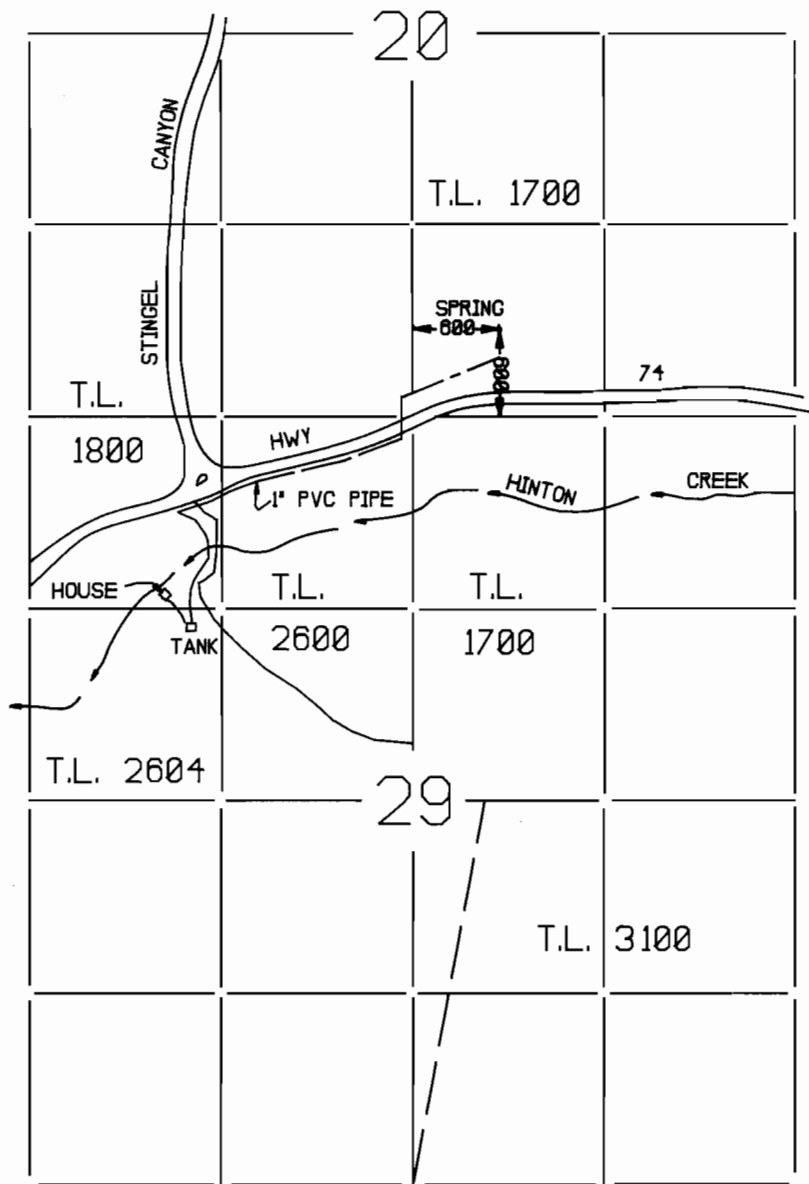

KRUMBEIN ENGINEERING LTD.
ENGINEERS — SURVEYORS — PLANNERS
361 S.E. Second Pendleton, Oregon

Scale
1"=1320'
Date
6-14-91

Drn. By
MJP
Ckd. By
DNK


Drng. No.
Job No.
888

Revision 1
Revision 2

FINAL PROOF SURVEY

RAY FRENCH

SEC. 29, T. 2S., R. 27 E.

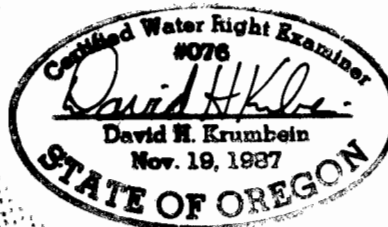

A 69525
P 50600