


30 29
31 32

T. 4 S., R. 10 W., W.M.

SW 1/4 of the NW 1/4, Sec. 32
TILLAMOOK COUNTY, OREGON

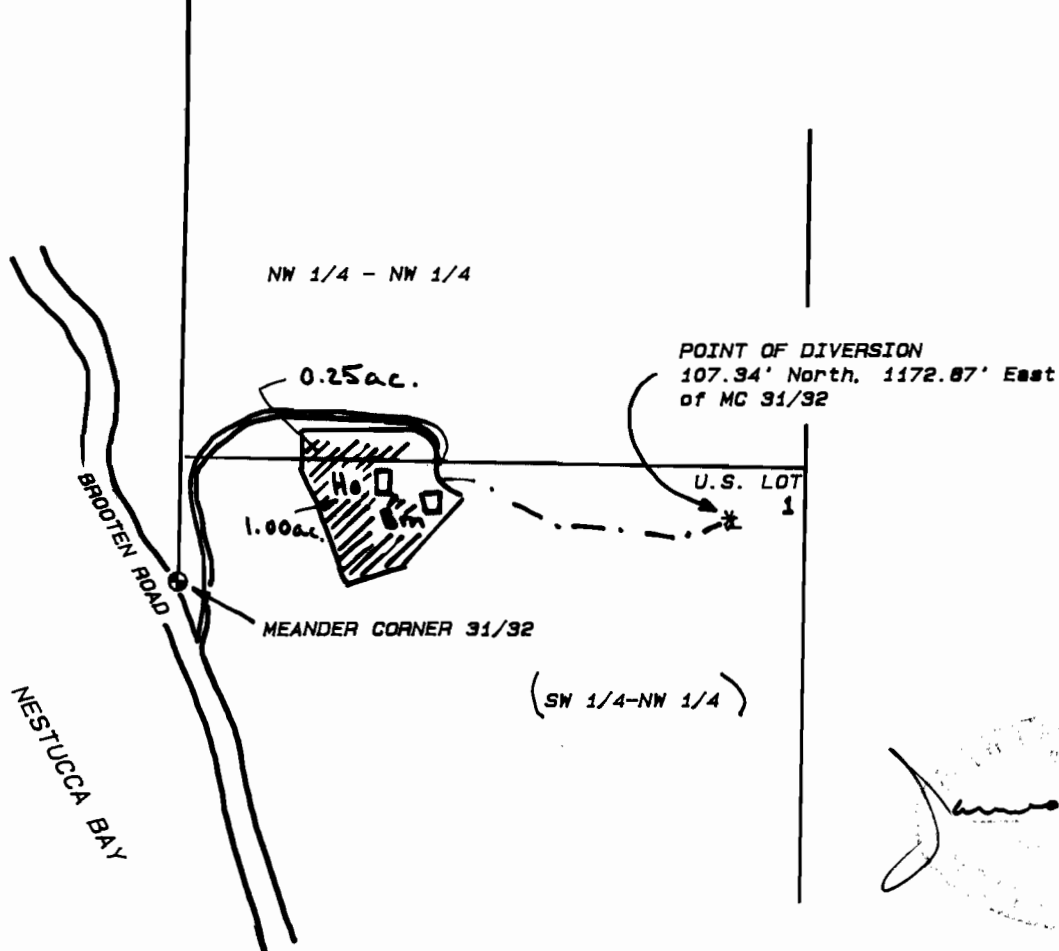

SCALE: 1" = 400'

James M. Denison

FINAL PROOF SURVEY

UNDER

Application No. 69531, Permit No. 50381

IN NAME OF

Nicholas and Karen Gelbard

Surveyed January 27, 1989 by James M. Denison

This map is prepared solely for the purpose of showing location of a water right, and is not intended for use to provide dimensions or location of property ownership lines.