


# T. 23S. .R. 13W. .W.M.


LEGEND

PREPARED BY: STUNTZNER ENG & FOR  
 P.O. BOX 118/705 S4th  
 COOS BAY, OREGON

POD#3  
 N42°E 2700'  
 FROM 1/4 S35/S36

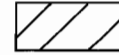


IRRIGATION

 


PROP LINE




POD

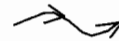

UNNAMED CR

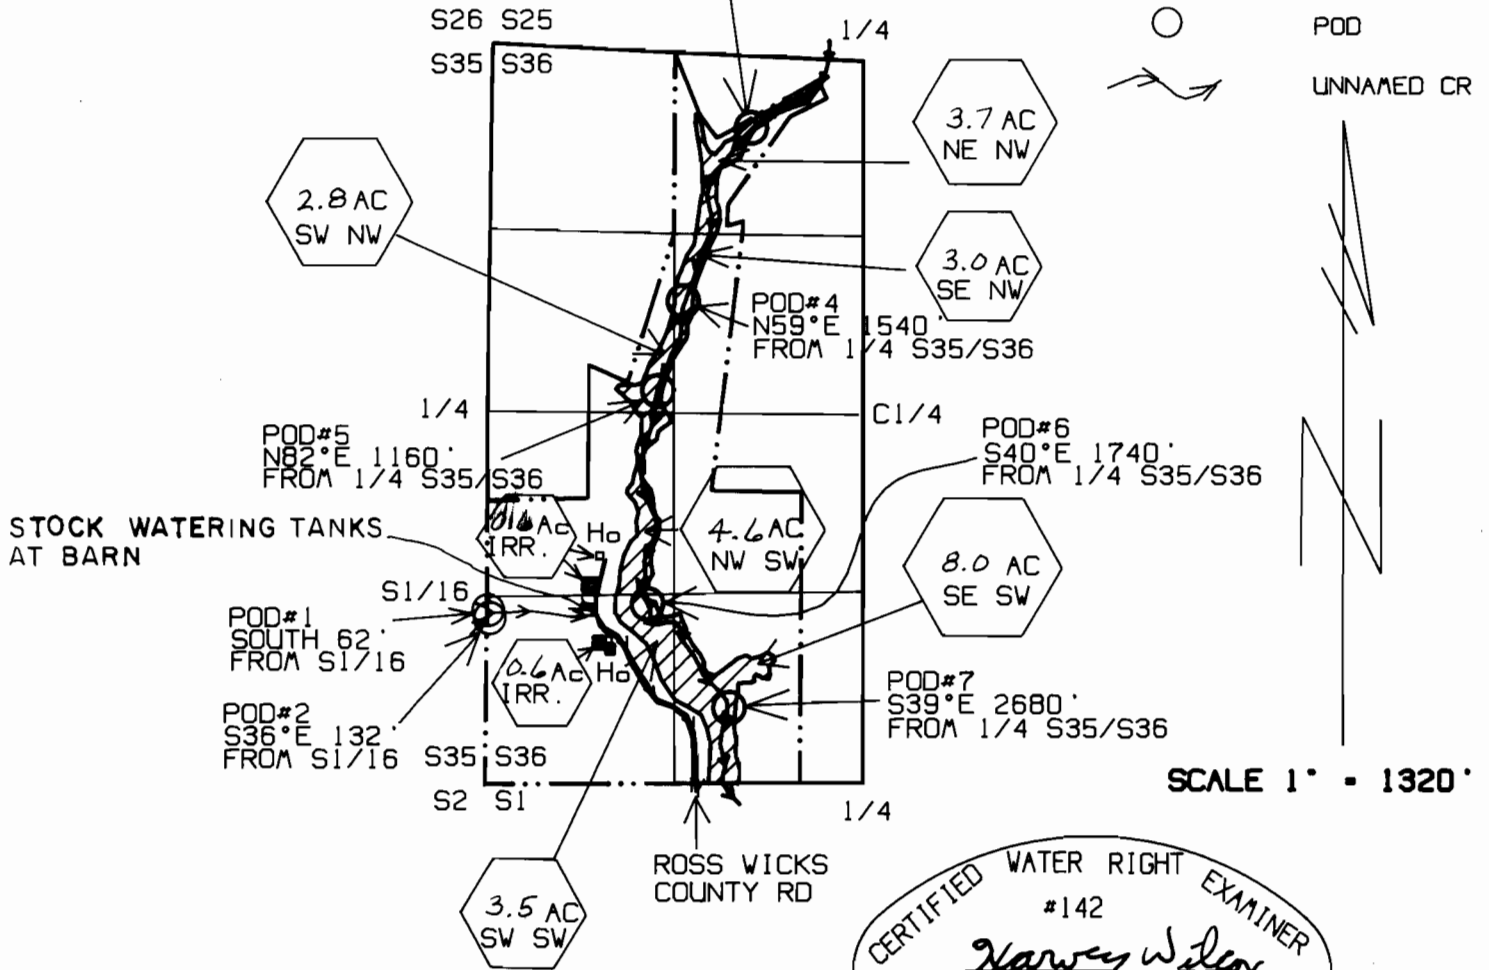

SCALE 1" = 1320'

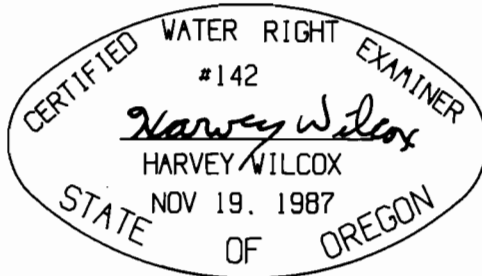

**EXAMINERS DISCLAIMER STATEMENT**

THE PREPARATION OF THIS MAP WAS FOR THE PURPOSE OF IDENTIFYING THE LOCATION OF THE WATER RIGHT ONLY AND HAS NO INTENT TO PROVIDE DIMENSIONS OR LOCATION OF OWNERSHIP LINES.

## FINAL PROOF SURVEY

Application No. 69577... Permit No. .50602....

IN NAME OF

..... CARL A. ROSS, JR. ....

Surveyed .JANUARY. 29. 1991... by ..H.A. WILCOX