


T. 28 S., R. 11 W. W. M.

FINAL PROOF SURVEY

Scale: 1" = 400 ft.

Surveyed Nov. 5, 1991.

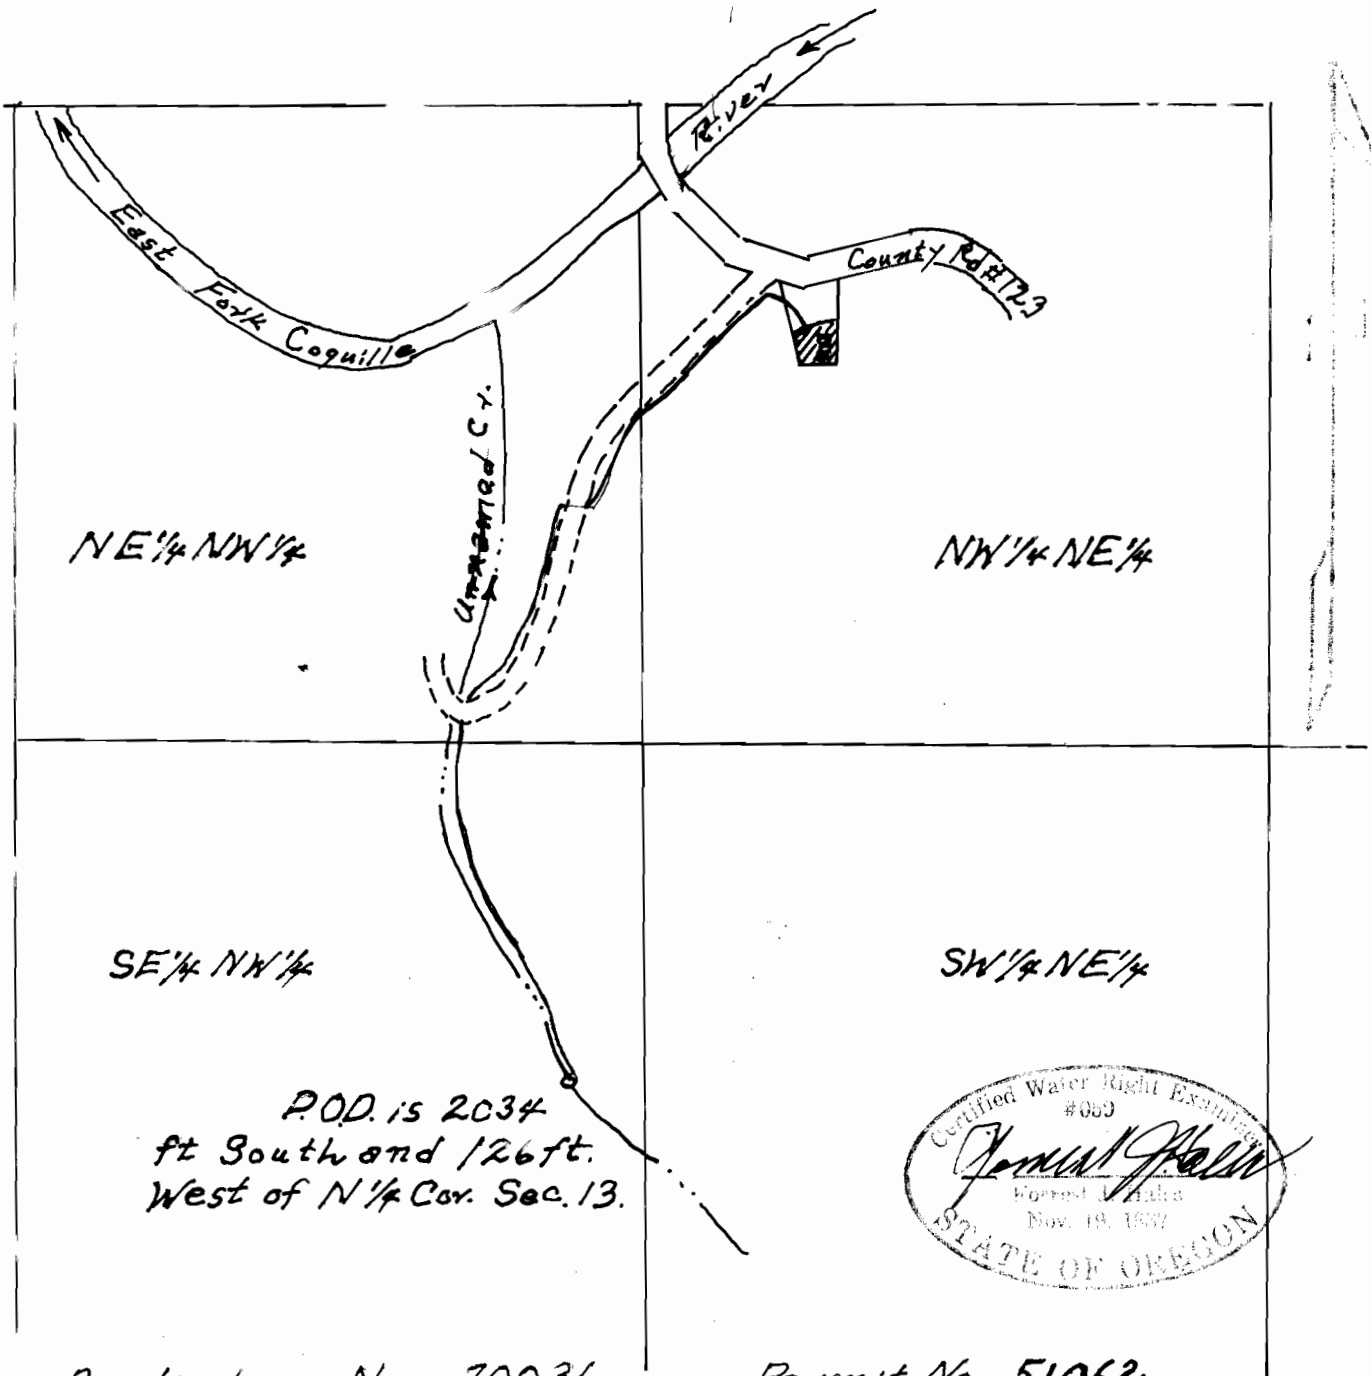

Application No. 70036
In the name of

Permit No. 51062
ALONZO S. GOODIN