


T.27S.R.6W.W.M.

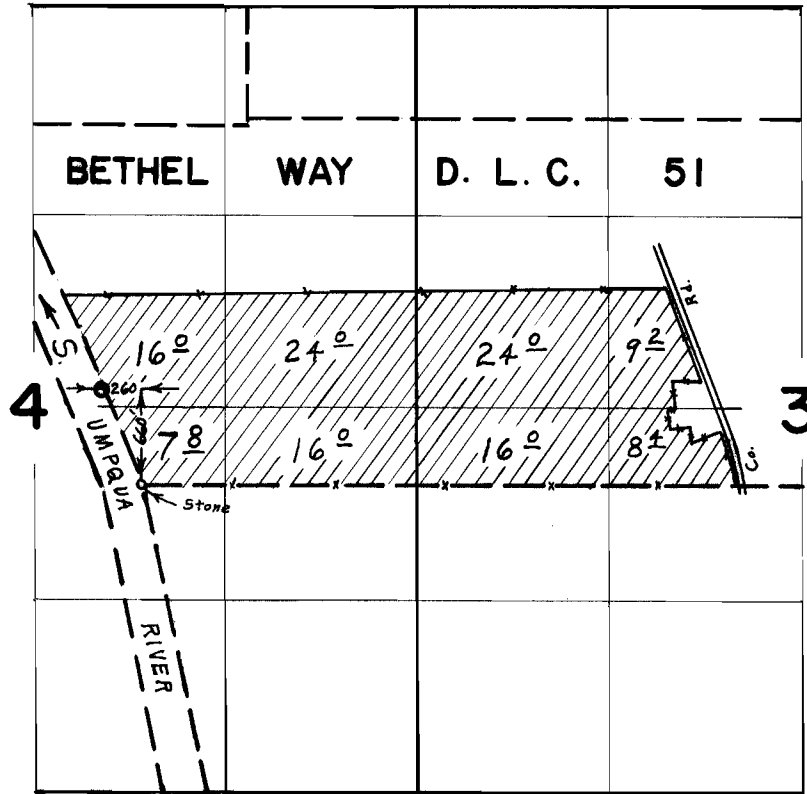

FINAL PROOF SURVEY UNDER

Application No. 37557 Permit No. 27985
IN NAME OF
G. W. TIPTON

Surveyed May 19 1966, by L. E. Gould