


T. 36S., R. 12E., W.M.

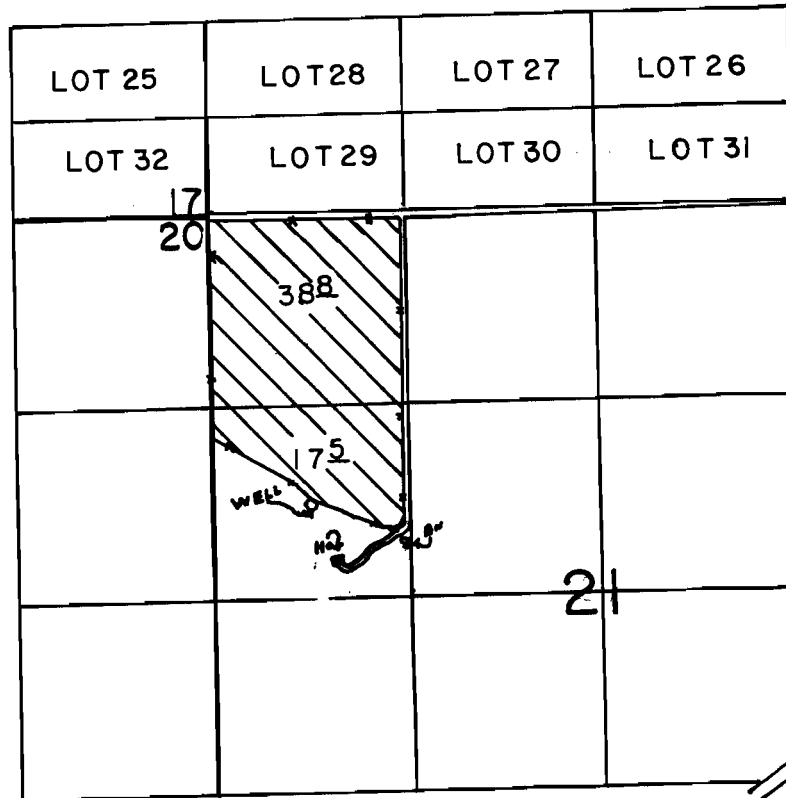

WELL LOC.: 2000' S. & 650' E. FROM NW COR. OF SEC 21.

SCALE: 1" = 1320'

FINAL PROOF SURVEY
UNDER

Application No. G-7253 Permit No. G-6375...
IN NAME OF

.....ROY MARTIN.....

Surveyed JUNE 19, 1991, by B.W. BISHOP.