


6-6754
67553

T. 41S., R. 14E., W.M.

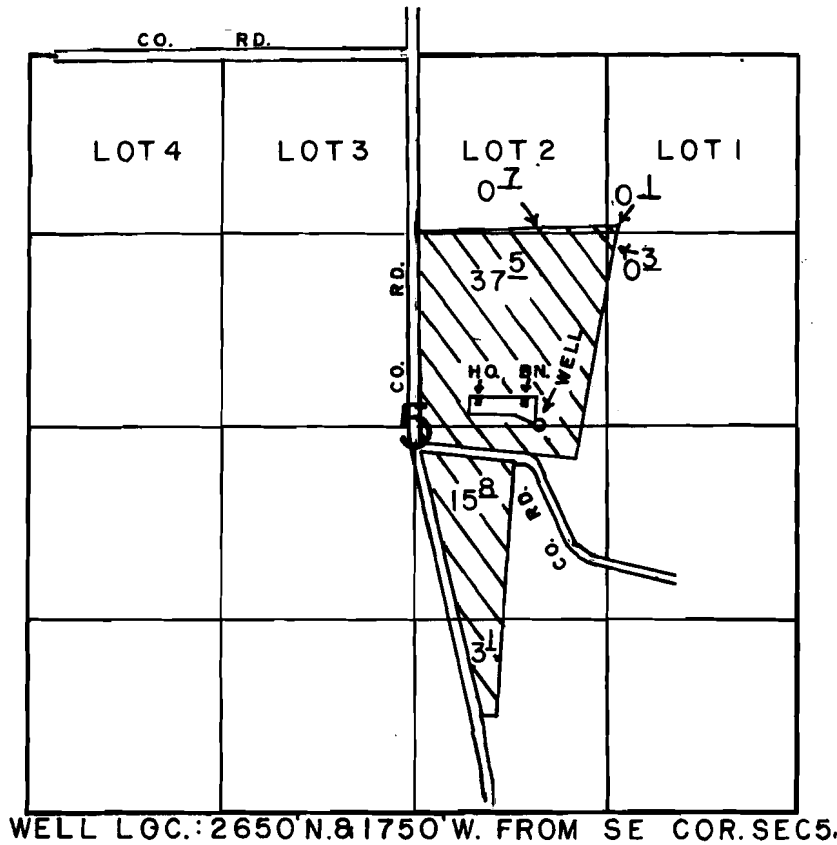

SCALE: 1" = 1320'

FINAL PROOF SURVEY UNDER

Application No. G.-7.305 Permit No. G.-6.754...
IN NAME OF

.....BRUCE ROBERT VOSS.....

Surveyed MAY 2... 19 91, by B.W. BISHOP...

East Area Wells