


T.22 S. R.31 E. W.M.

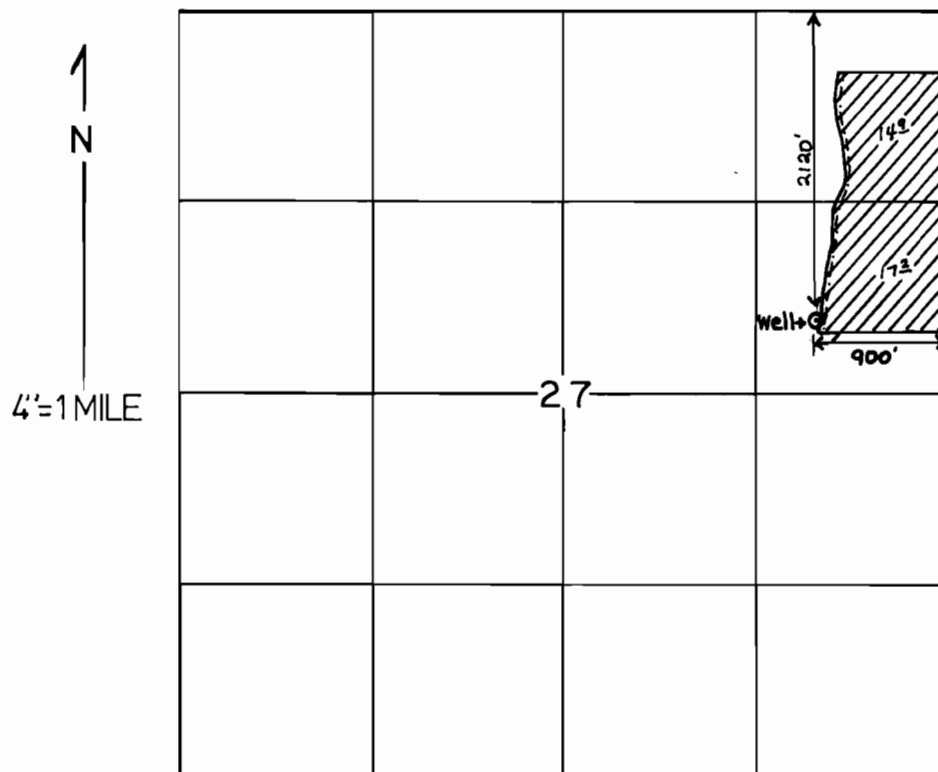

FINAL PROOF SURVEY
UNDER

Application No. G-7889 Permit No. G-7438
IN NAME OF

THAD GEER

Surveyed 9-26... 1991., by J. Miller

41025-279171R
NCR
JM 1-21-92