


T. 17 S., R. 17 E., W.M.

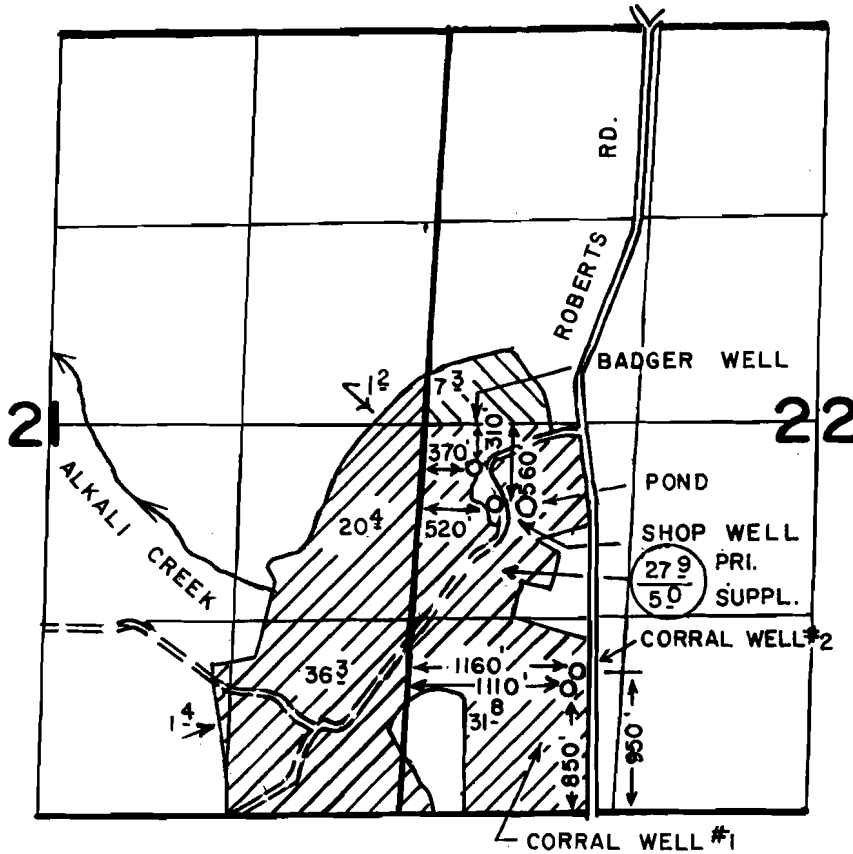

 PRIMARY IRRIGATION
 SUPPLEMENTAL IRRIGATION

FINAL PROOF SURVEY UNDER

Application No. G-9546 Permit No. G-8845
 IN NAME OF

JAMES O. ARNTZ

Surveyed FEB. 21 1990, by B.W. BISHOP

67555

4-9-90 DSM
 41013-180-106L

G-8845

RECEIVED OCT 13 1992

1"=1320'