
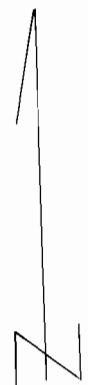


T. 16S., R. 44E., W.M.

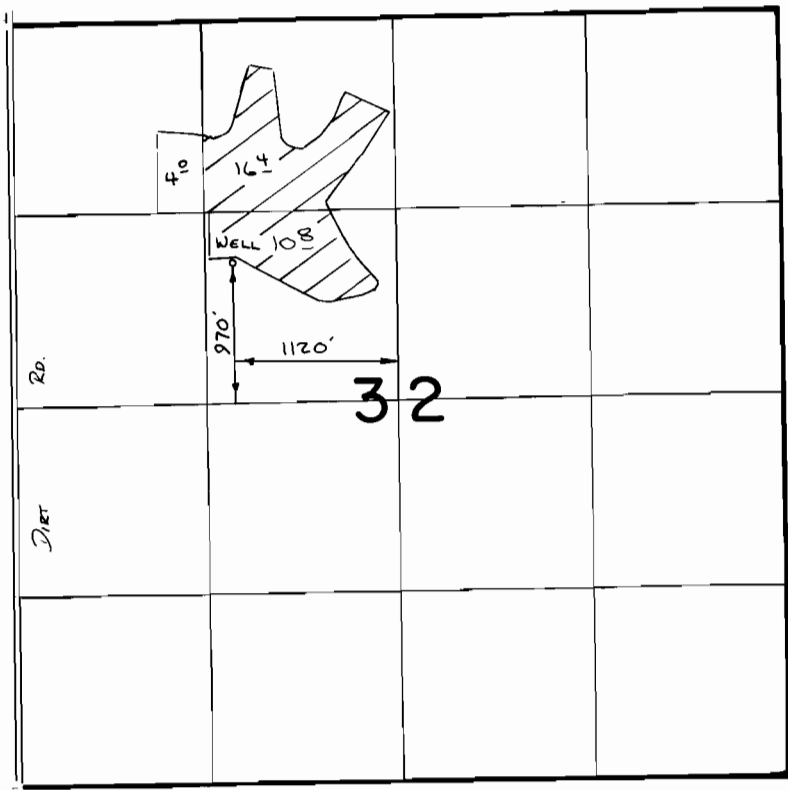

SCALE 1" = 1320'

FINAL PROOF SURVEY UNDER

Application No. G:9652 Permit No. G:9381... IN NAME OF

W.W. & WILMA J. DELONG.....

Surveyed 4-12..... 1988, by K.H. Church.....