



T.26S., R.31E., W.M.

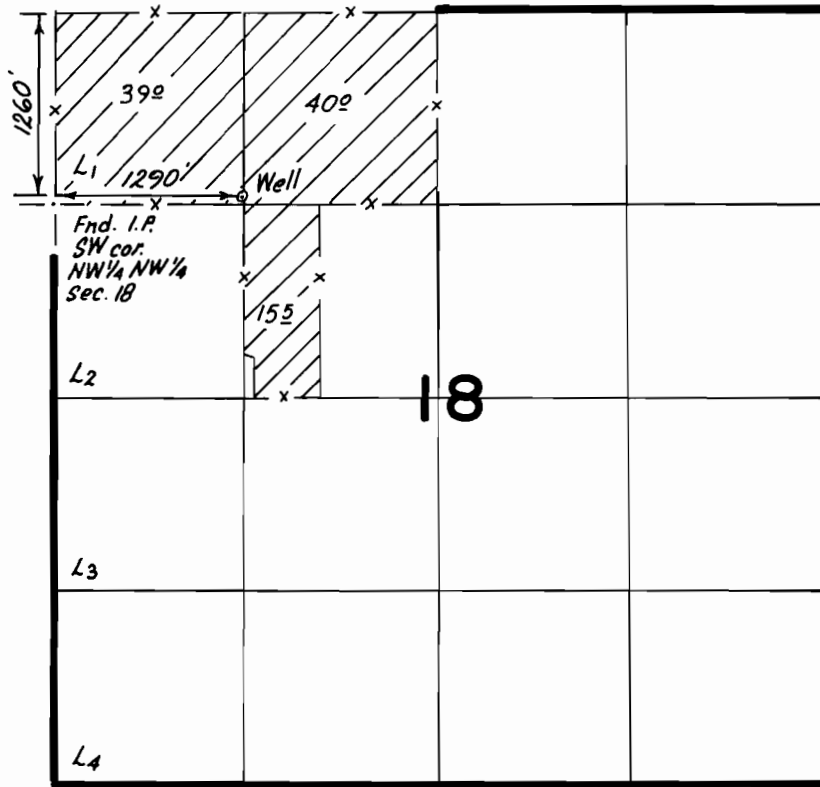

FINAL PROOF SURVEY

UNDER

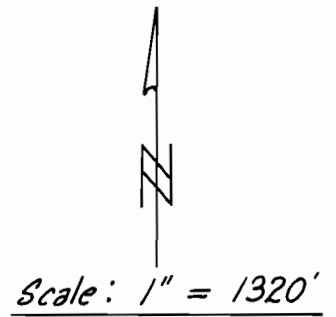

Application No. **G9722** Permit No. **G8978**...
 IN NAME OF

.....**STEVE & INEZ WILSON**.....

Surveyed ..5..6..... 1988.., by ..Tom..Warren.....