



# T.1S., R.44E., W.M.

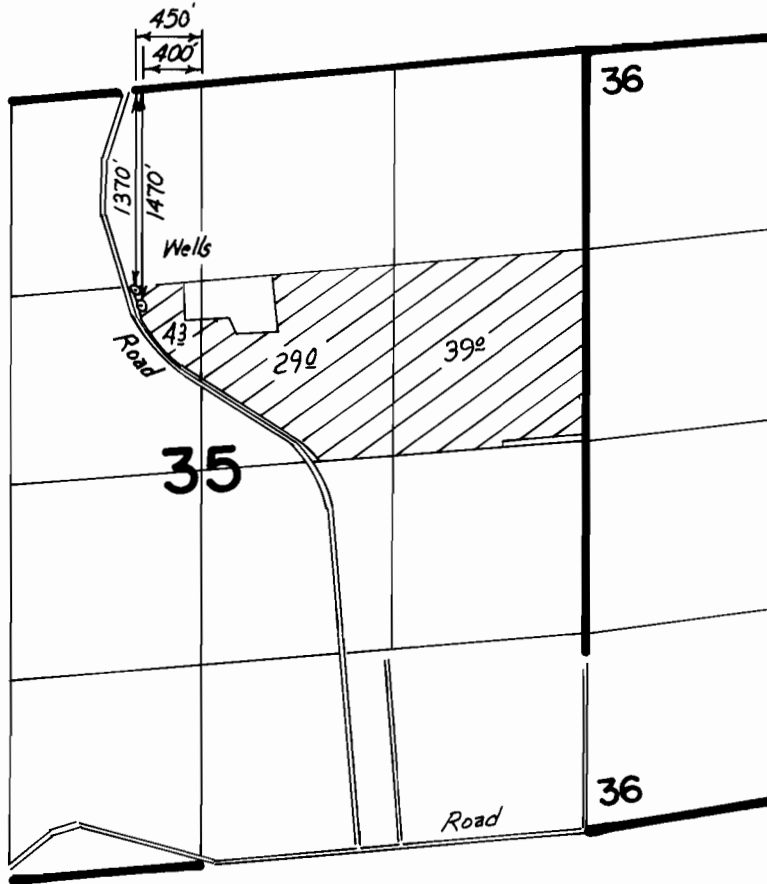

## FINAL PROOF SURVEY UNDER

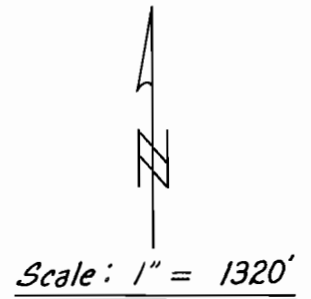

Application No. **G9746** Permit No. **G9011**.....  
IN NAME OF

.....**J.D. BANE**.....

Surveyed **8-9**..... 1988., by **Verna Church**.....