


T. 32 S., R. 5 W., W. M.

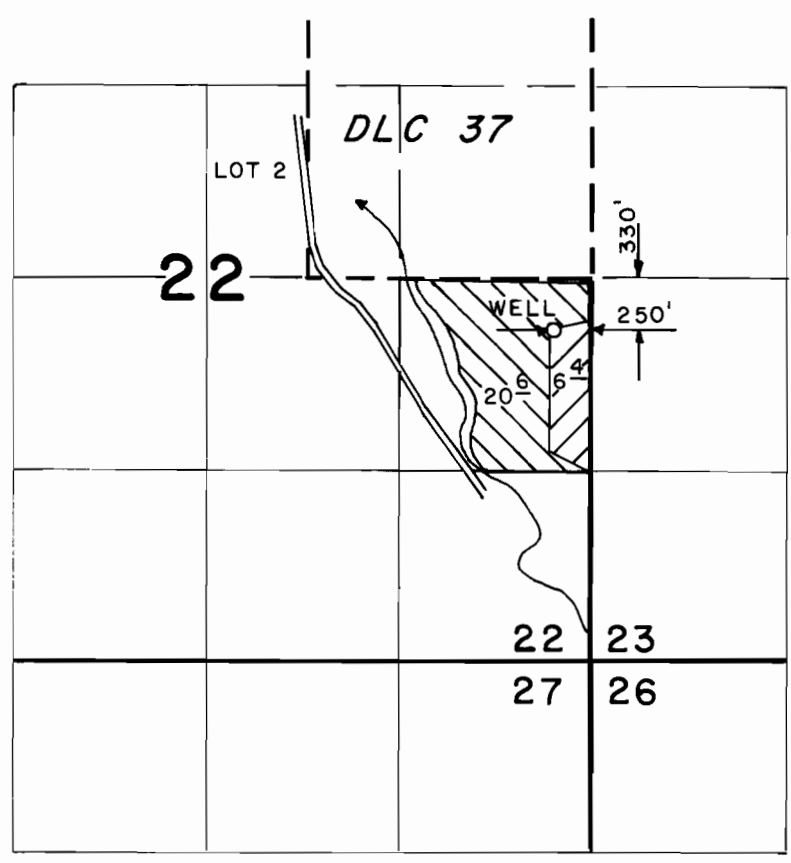

SCALE: 4" = 1 MILE

PRIMARY  SUPPLEMENTAL 

FINAL PROOF SURVEY
UNDER

Application No. G-9813... Permit No. G-9545...
IN NAME OF

HENRY C. AND GLENORA M. TANNER

Surveyed JULY 7, 1988, by J. M. SCHMORDE