


G-9229
67560

T.26S., R.17E., W.M.

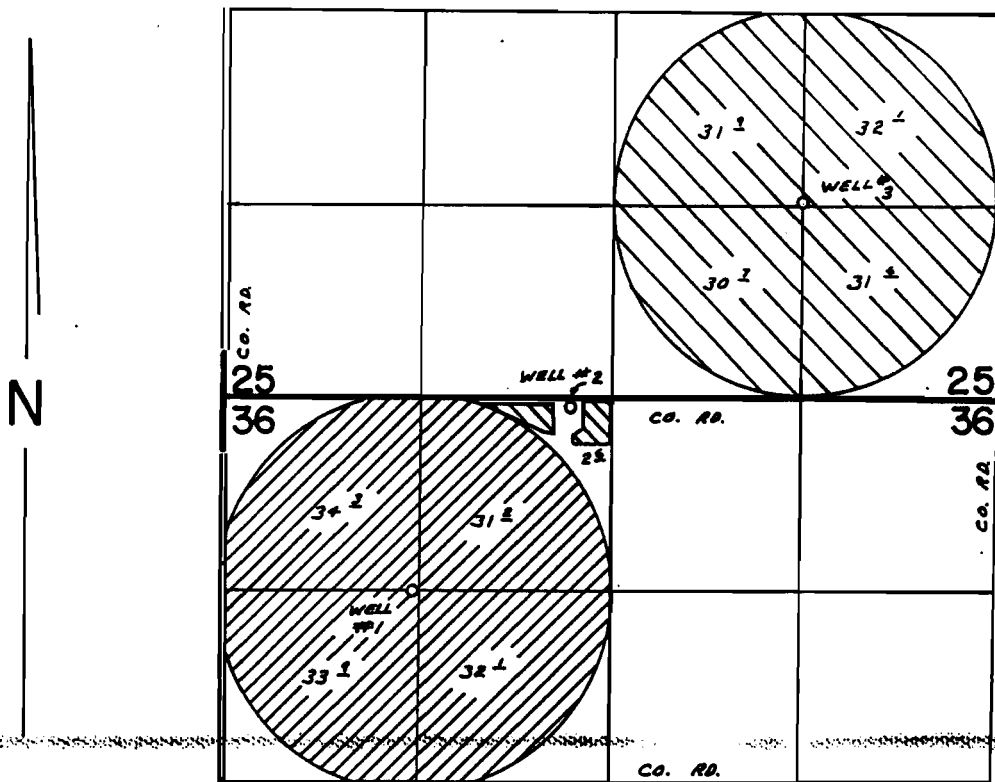

WELL #1 LOC.: 50' S & 2400' E. FROM SW COR. SEC. 25
WELL #2 LOC.: 1320' S & 1300' E FROM SW COR. SEC. 25
WELL #3 LOC.: 1340' N & 1320' W FROM SE COR. SEC. 25

SCALE: 1"=1320'

-  G-9229
-  G-9275 Well No. 2
-  G-9275 Well No. 1

FINAL PROOF SURVEY UNDER

Application No. G-10042 G-9229
G-10167 Permit No. G-9275
IN NAME OF

BIRCH CIRCLE FARMS

Surveyed AUG. 30. 1988, by B. BISHOP