


G-9275
67561

T.26S., R.17E., W.M.

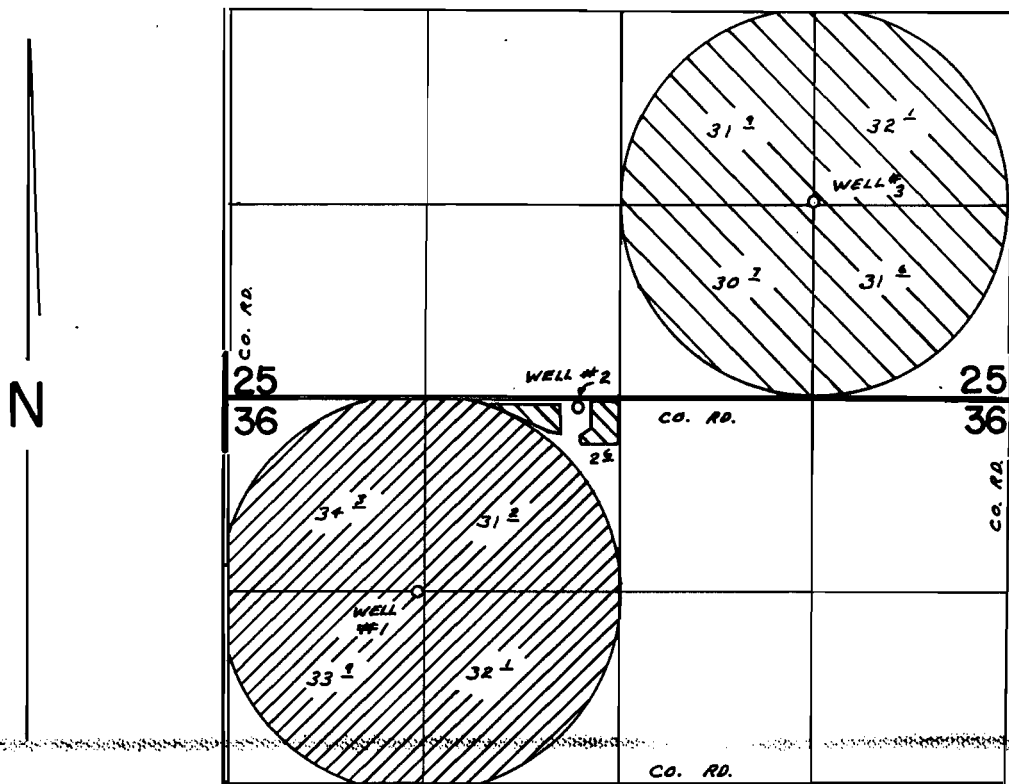

WELL #1 LOC.: 50'S & 2400'E. FROM SW COR. SEC. 25
WELL #2 LOC.: 1320'S & 1300'E FROM SW COR. SEC. 25
WELL #3 LOC.: 1340'N & 1320'W FROM SE COR. SEC. 25

SCALE: 1"=1320'

 G-9229

 G-9275 Well No. 2

 G-9275 Well No. 1

FINAL PROOF SURVEY UNDER

Application No. G-10042 Permit No. G-9229
G-10167 G-9275
IN NAME OF

BIRCH CIRCLE FARMS

Surveyed AUG. 30. 1988, by B. BISHOP

PTS 11-1988

1-13-89
J.P.C.