


G-9644
67565

T. 35S., R. 10E., W.M.

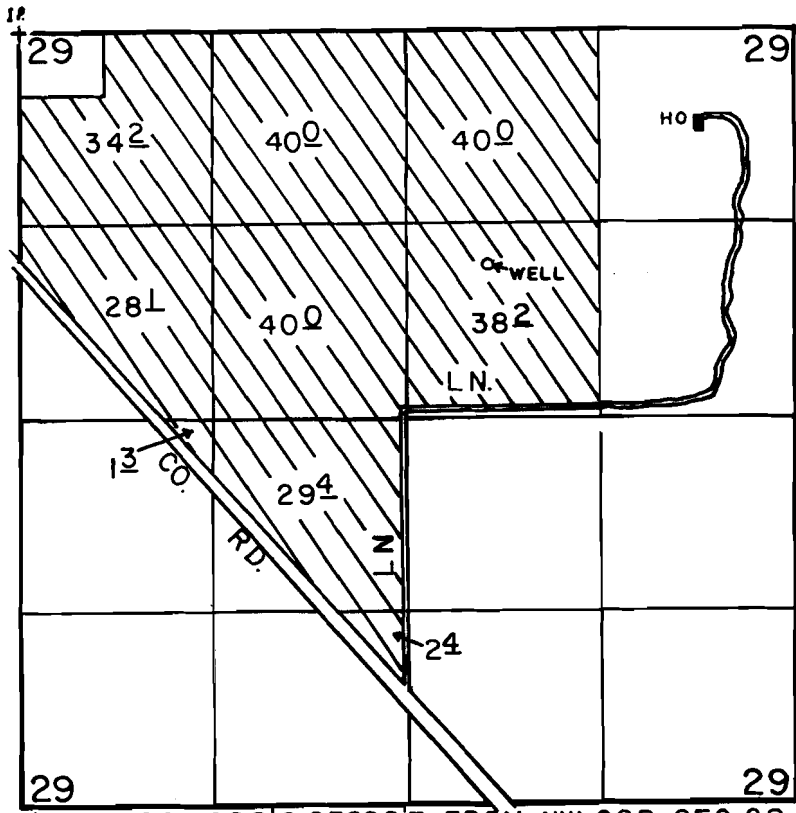

WELL LOC.: 1600' S. 83200' E. FROM NW COR. SEC 29

SCALE: 1" = 1320'

FINAL PROOF SURVEY UNDER

Application No. G-10473 Permit No. G-9644.....
IN NAME OF

....ROBERT...JENNINGS...SANDERS....

Surveyed APRIL 22 19.91., by B.W. BISHOP.

Map of Sec 29