


T. 23S., R. 32E., W.M.

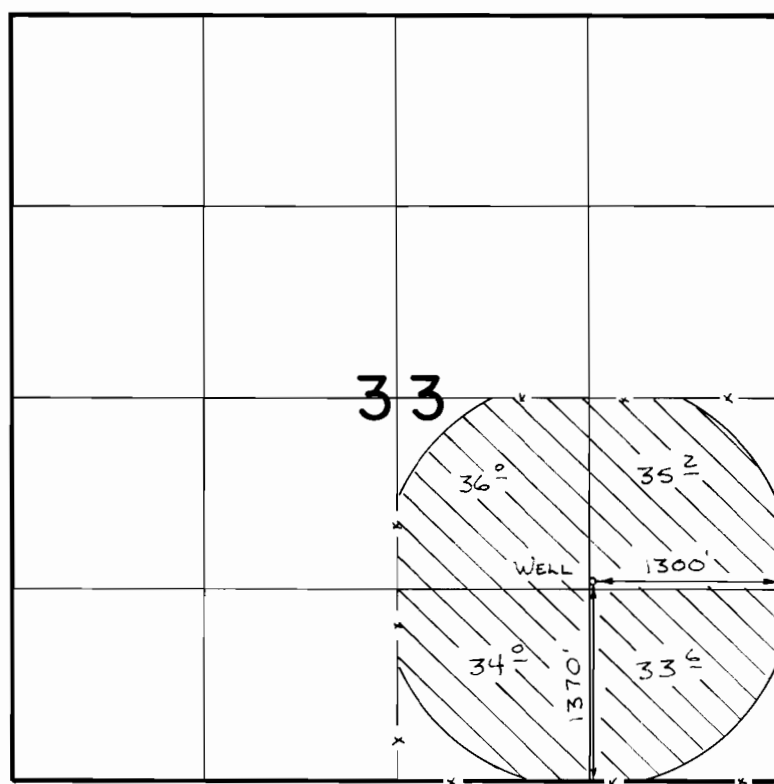

SCALE 1" = 1320'

FINAL PROOF SURVEY
UNDER

Application No. ~~G:10520~~ Permit No. ~~G:9876~~
IN NAME OF

.....JOSEPH.....W.....LANGENFIELD.....

Surveyed ..5-7..... 19.88, by *V.L. Church*.....