


T. 23 S., R. 5 W., W. M.

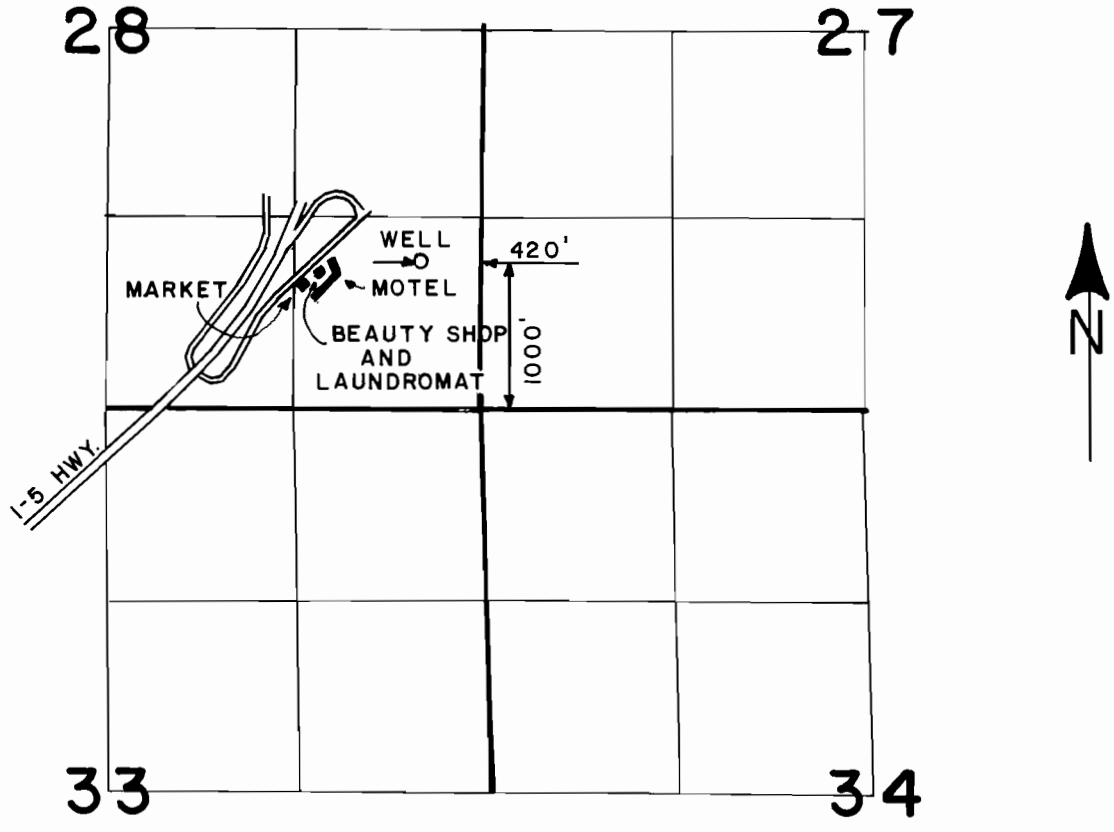

SCALE: 4" = 1 MILE

**FINAL PROOF SURVEY**  
UNDER

Application No. G-10570 Permit No. G-9749...  
IN NAME OF

**ROBERT TUCKER**

Surveyed AUG...18... 1988, by J.M. SCHMORDE