


T.5S., R.12 & 13 E., W.M.

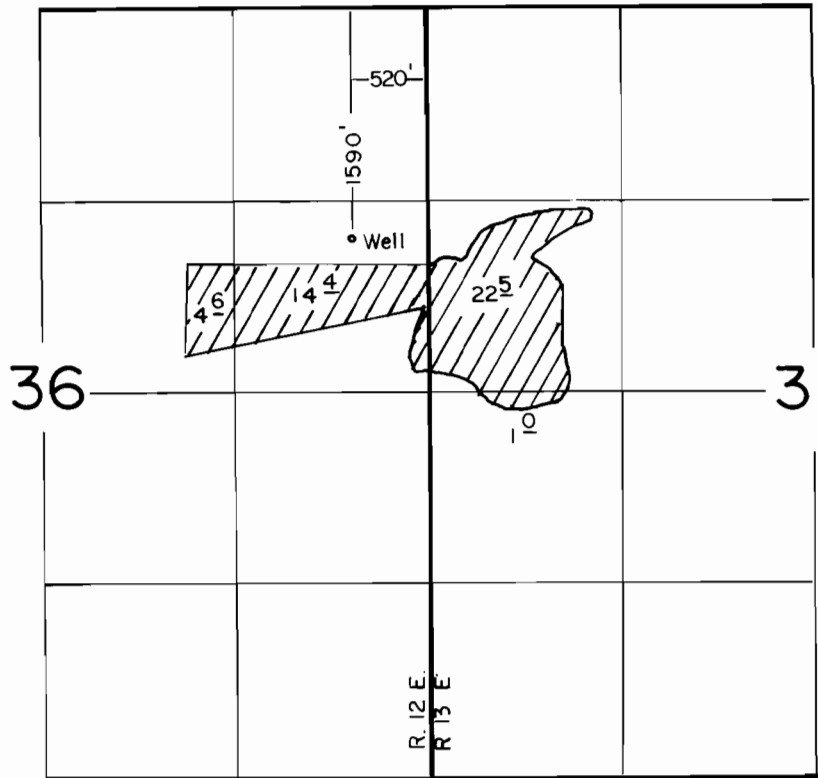

SCALE: 1" = 1320'

**FINAL PROOF SURVEY**  
UNDER

Application No. G-10646. Permit No. G-9782.....  
IN NAME OF

**EMILY E. LEWIS**

Surveyed OCT. 18. 1988., by Z.F. SALEH.....